


T. 35 S., R. 2 W., W. M.

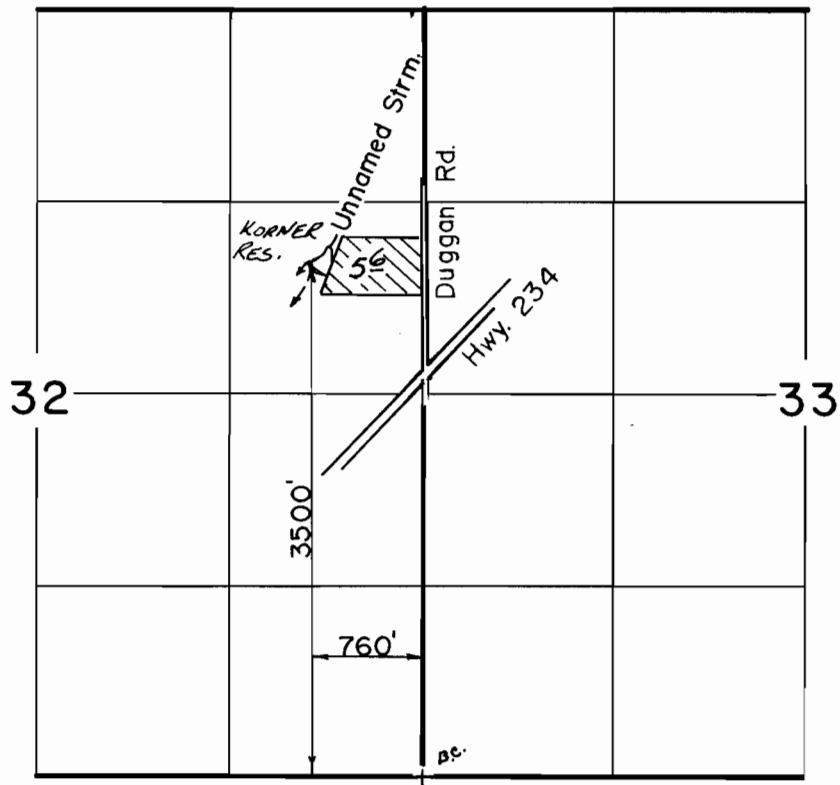

Scale: 1" = 1320'

FINAL PROOF SURVEY
UNDER

R-57479 R-7684
Application No. 57480 Permit No. 43342
IN NAME OF

DONALD B. KORNER

Surveyed MAY 21 1987, by B. S. JAMES