


# T. 4S. R. 10W. W.M.

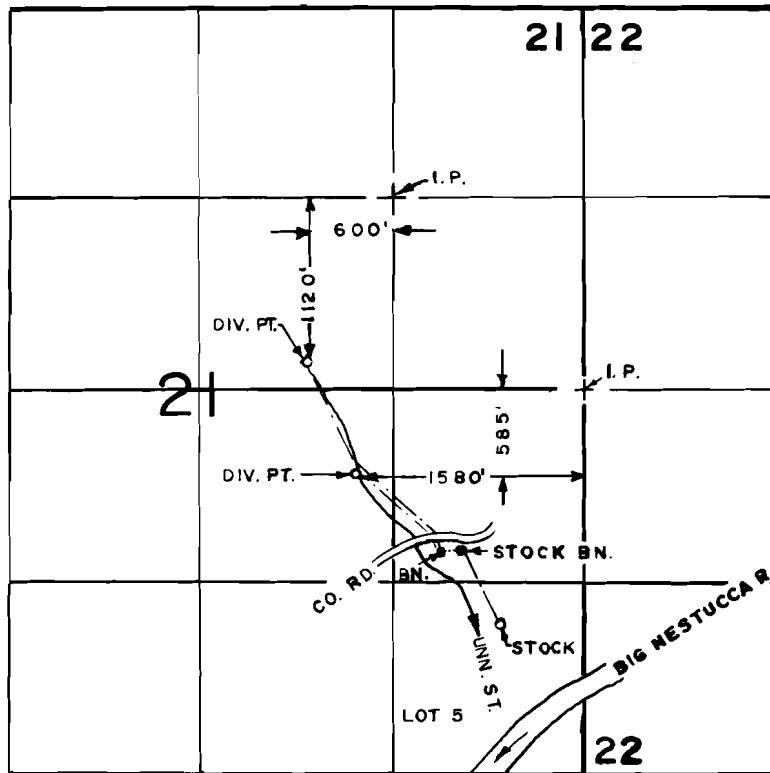

## FINAL PROOF SURVEY UNDER

Application No. 57521... Permit No. 43294...  
IN NAME OF

..... **JOHN E. & MILDRED HURLIMAN** .....

Surveyed **JAN. 24 1980.**, by **R.G. MUCKEN**.....