


T. 1N., R. 40E., W.M.

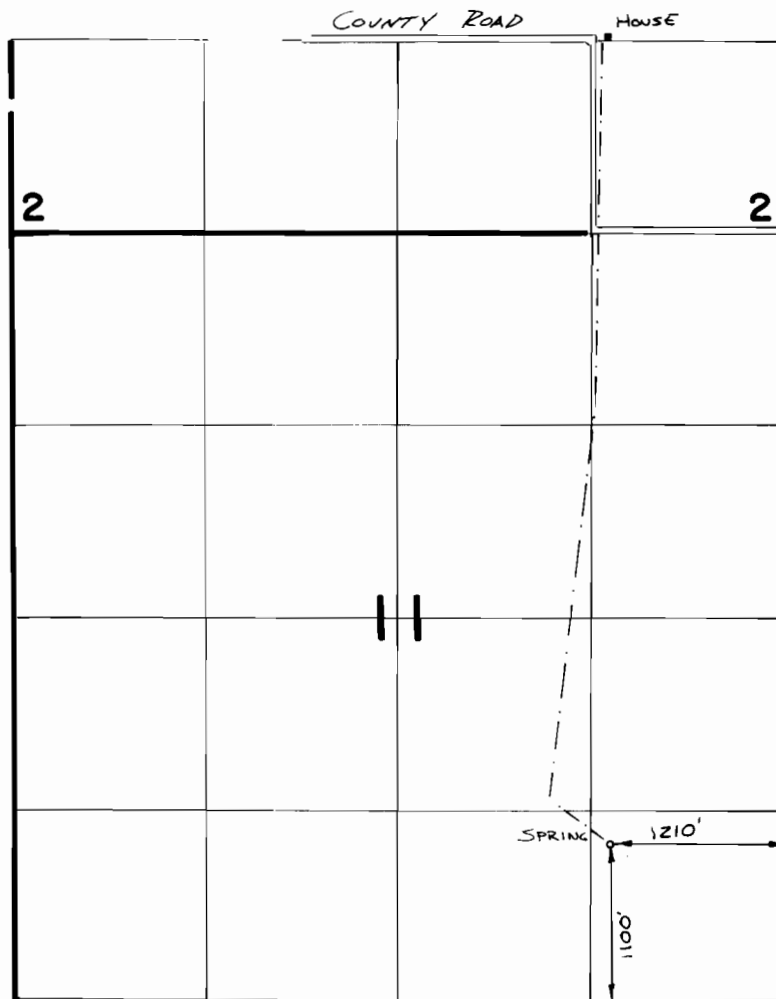

Scale: 1" = 1320'

FINAL PROOF SURVEY
UNDER

Application No. **57823** Permit No. **43655**
IN NAME OF

TIM K. & MARY A. WALLER

Surveyed 4-11 1988, by V.L. Church