


T. 2N., R. 5W., W.M.

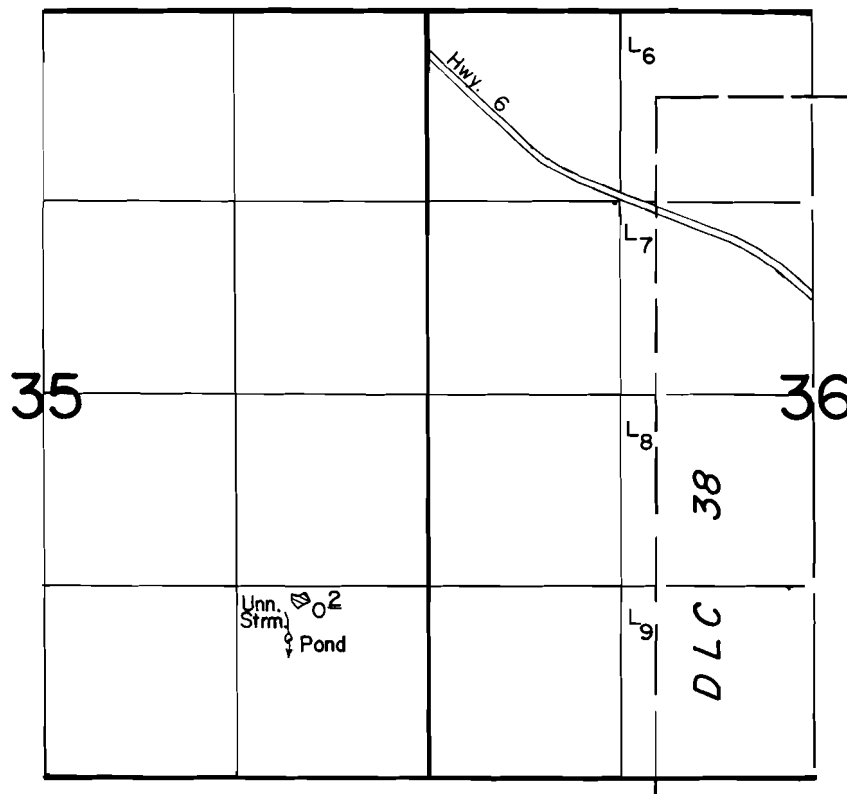

P.O.D. Loc. : 930' N. & 950' W. from SE Cor. Sec. 35.

Scale : 1" = 1320'

FINAL PROOF SURVEY

UNDER

R-58795 R-8542
 Application No. 58796 Permit No. 47190
 IN NAME OF

RALPH B. MARTIN

Surveyed March 28, 1988, by T. Warren