


T.16S., R.23E., W.M.

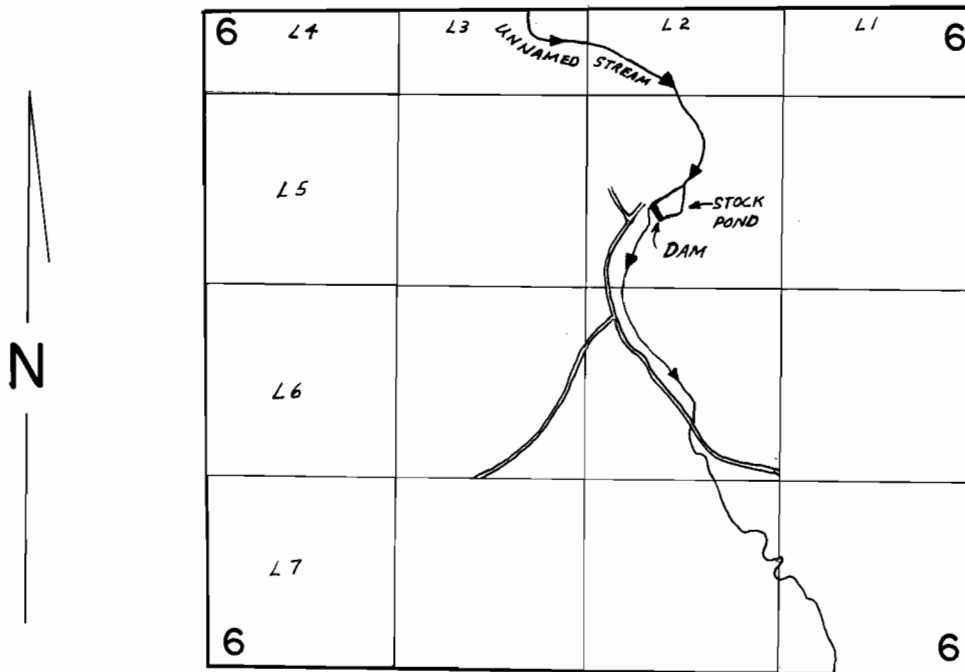

DAM LOC.: 500' N & 475' E. FROM THE C.1/4 COR. SEC. 6

SCALE: 1"=1320'

FINAL PROOF SURVEY UNDER

Application No. R-58874 Permit No. R-8120

IN NAME OF

RICHARD M. BEDORTHA

Surveyed AUG. 2 1988, by B. BISHOP