


T. 2N., R4W., W.M.

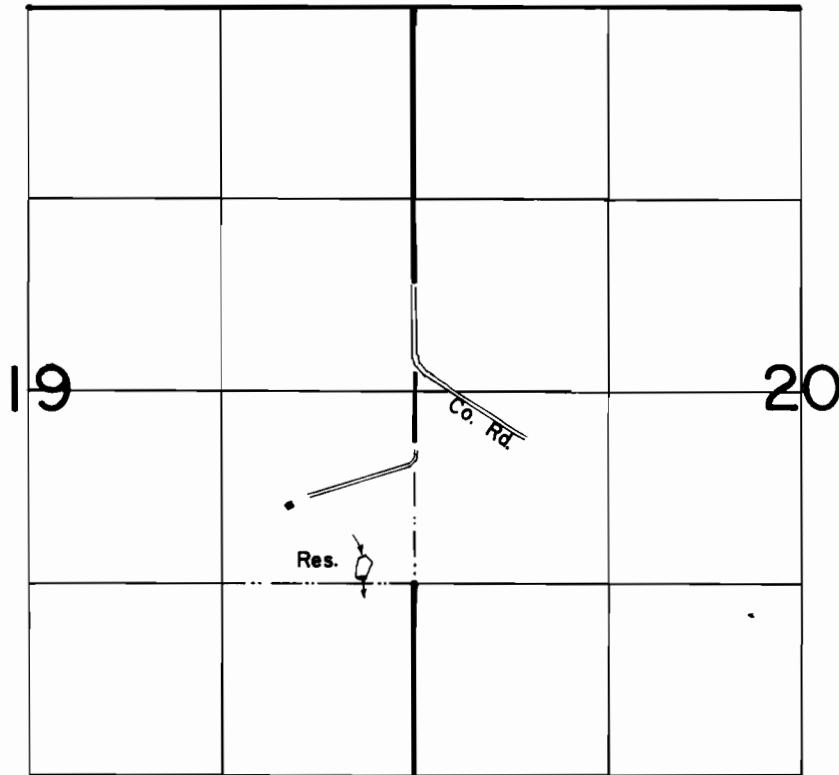

P.O.D. Loc. : 30' N. & 350' W. from SE Cor. NE 1/4 SE 1/4 Sec. 19.

Scale : 1" = 1320'

FINAL PROOF SURVEY

UNDER

R-59194

R-7959

Application No. 59195... Permit No. 44520.....

IN NAME OF

...ROBERT R. SHUMAKER.....

Surveyed AUG 9 1988, by T. Warren.....