


# T.9S. R.39E. W.M.

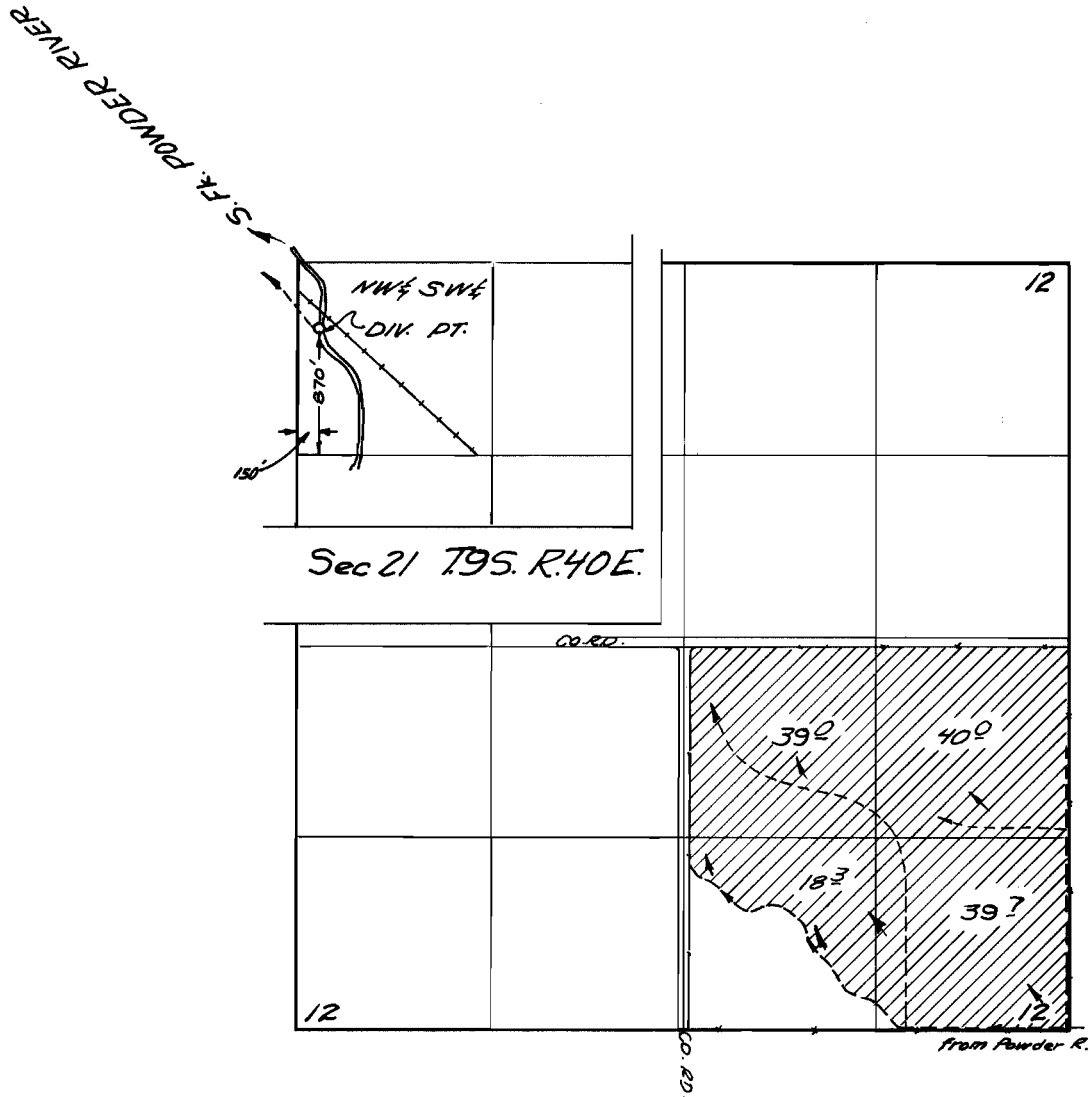

## FINAL PROOF SURVEY UNDER

Application No. 40956... Permit No. 30544...  
IN NAME OF

*EDYTHE McELROY and ALENE BROWN*

Surveyed July 26, 1967, by *V. Garner*.....