


T2S, R4E, WM

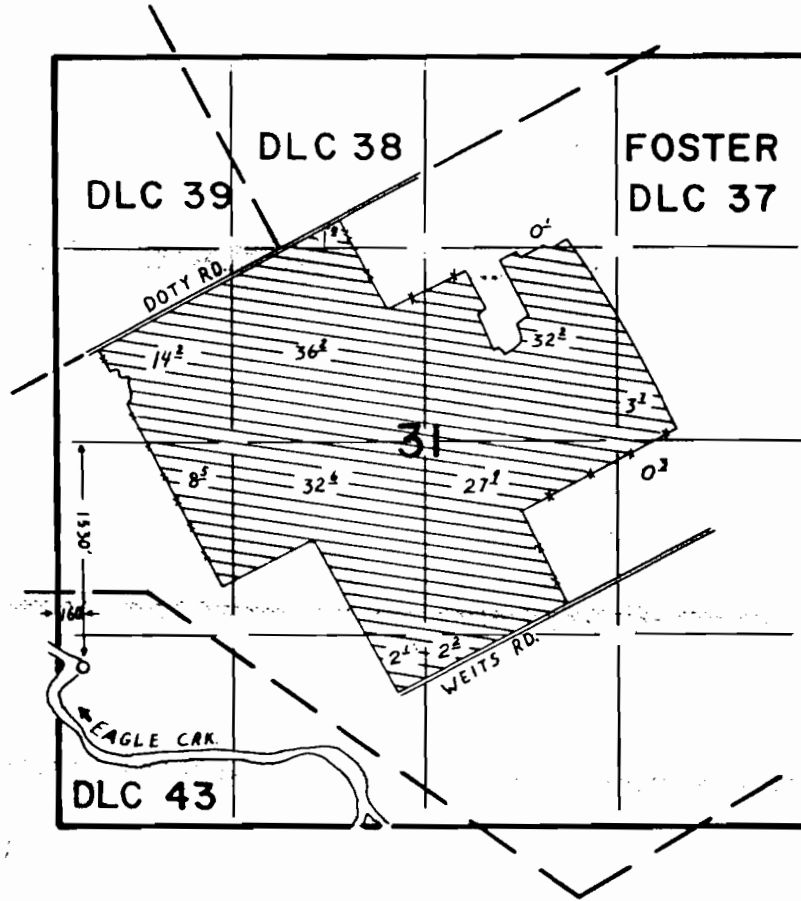

FINAL PROOF SURVEY UNDER

Application No. 60165.. Permit No. 45567.....
IN NAME OF

.....DAVID TIMM.....

Surveyed JULY 1.... 1987., by T.M. WARREN...