
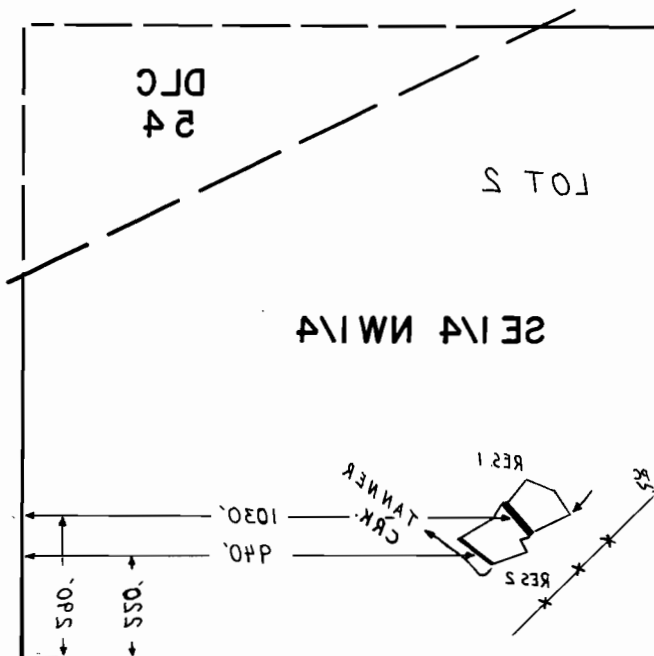


SEC 36 T2S, R1E, WM

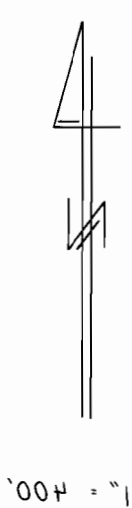

FINAL PROOF SURVEY UNDER

Surveyed June 3, 1987, by T.M. WARREN
 IN NAME OF JONATHAN PRICE COX
 Application No. 20178 Permit No. 46693
 R-60177 R-8406