


T.20S., R. 25E., W.M.

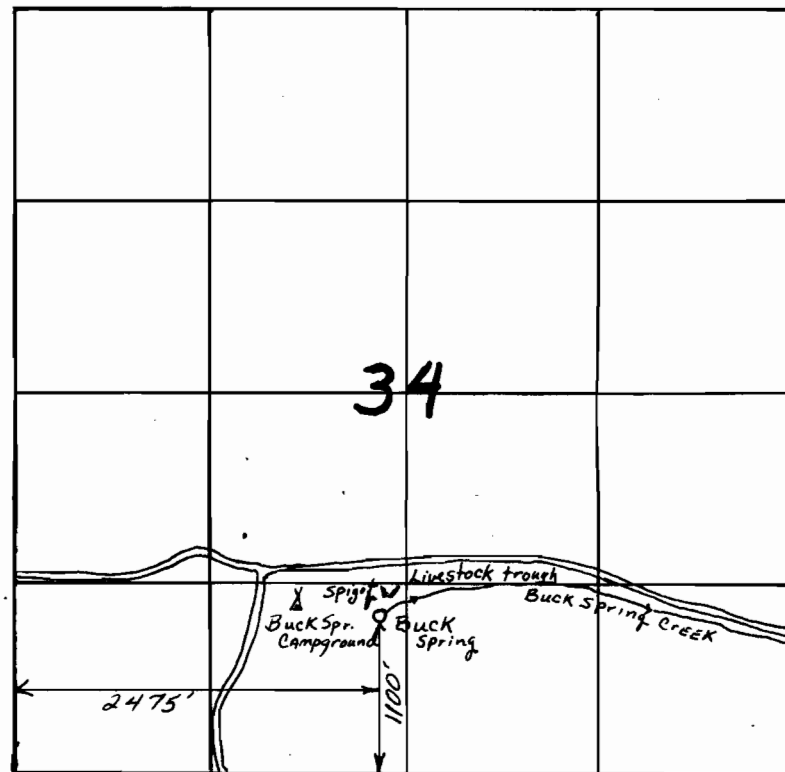

SCALE - 4" = 1 MILE

Application No. 60882
Permit No. 48535

RECEIVED
MAY 6 1983
WATER RESOURCES DEPT.
SALEM, OREGON