

1" = 100'

See Map 18 10

RECEIVED


MAR 24 1982

WATER RESOURCES DEPT  
SALEM, OREGON

RECEIVED

SEP 2

WATER RESOURCES  
SALEM, OREGON

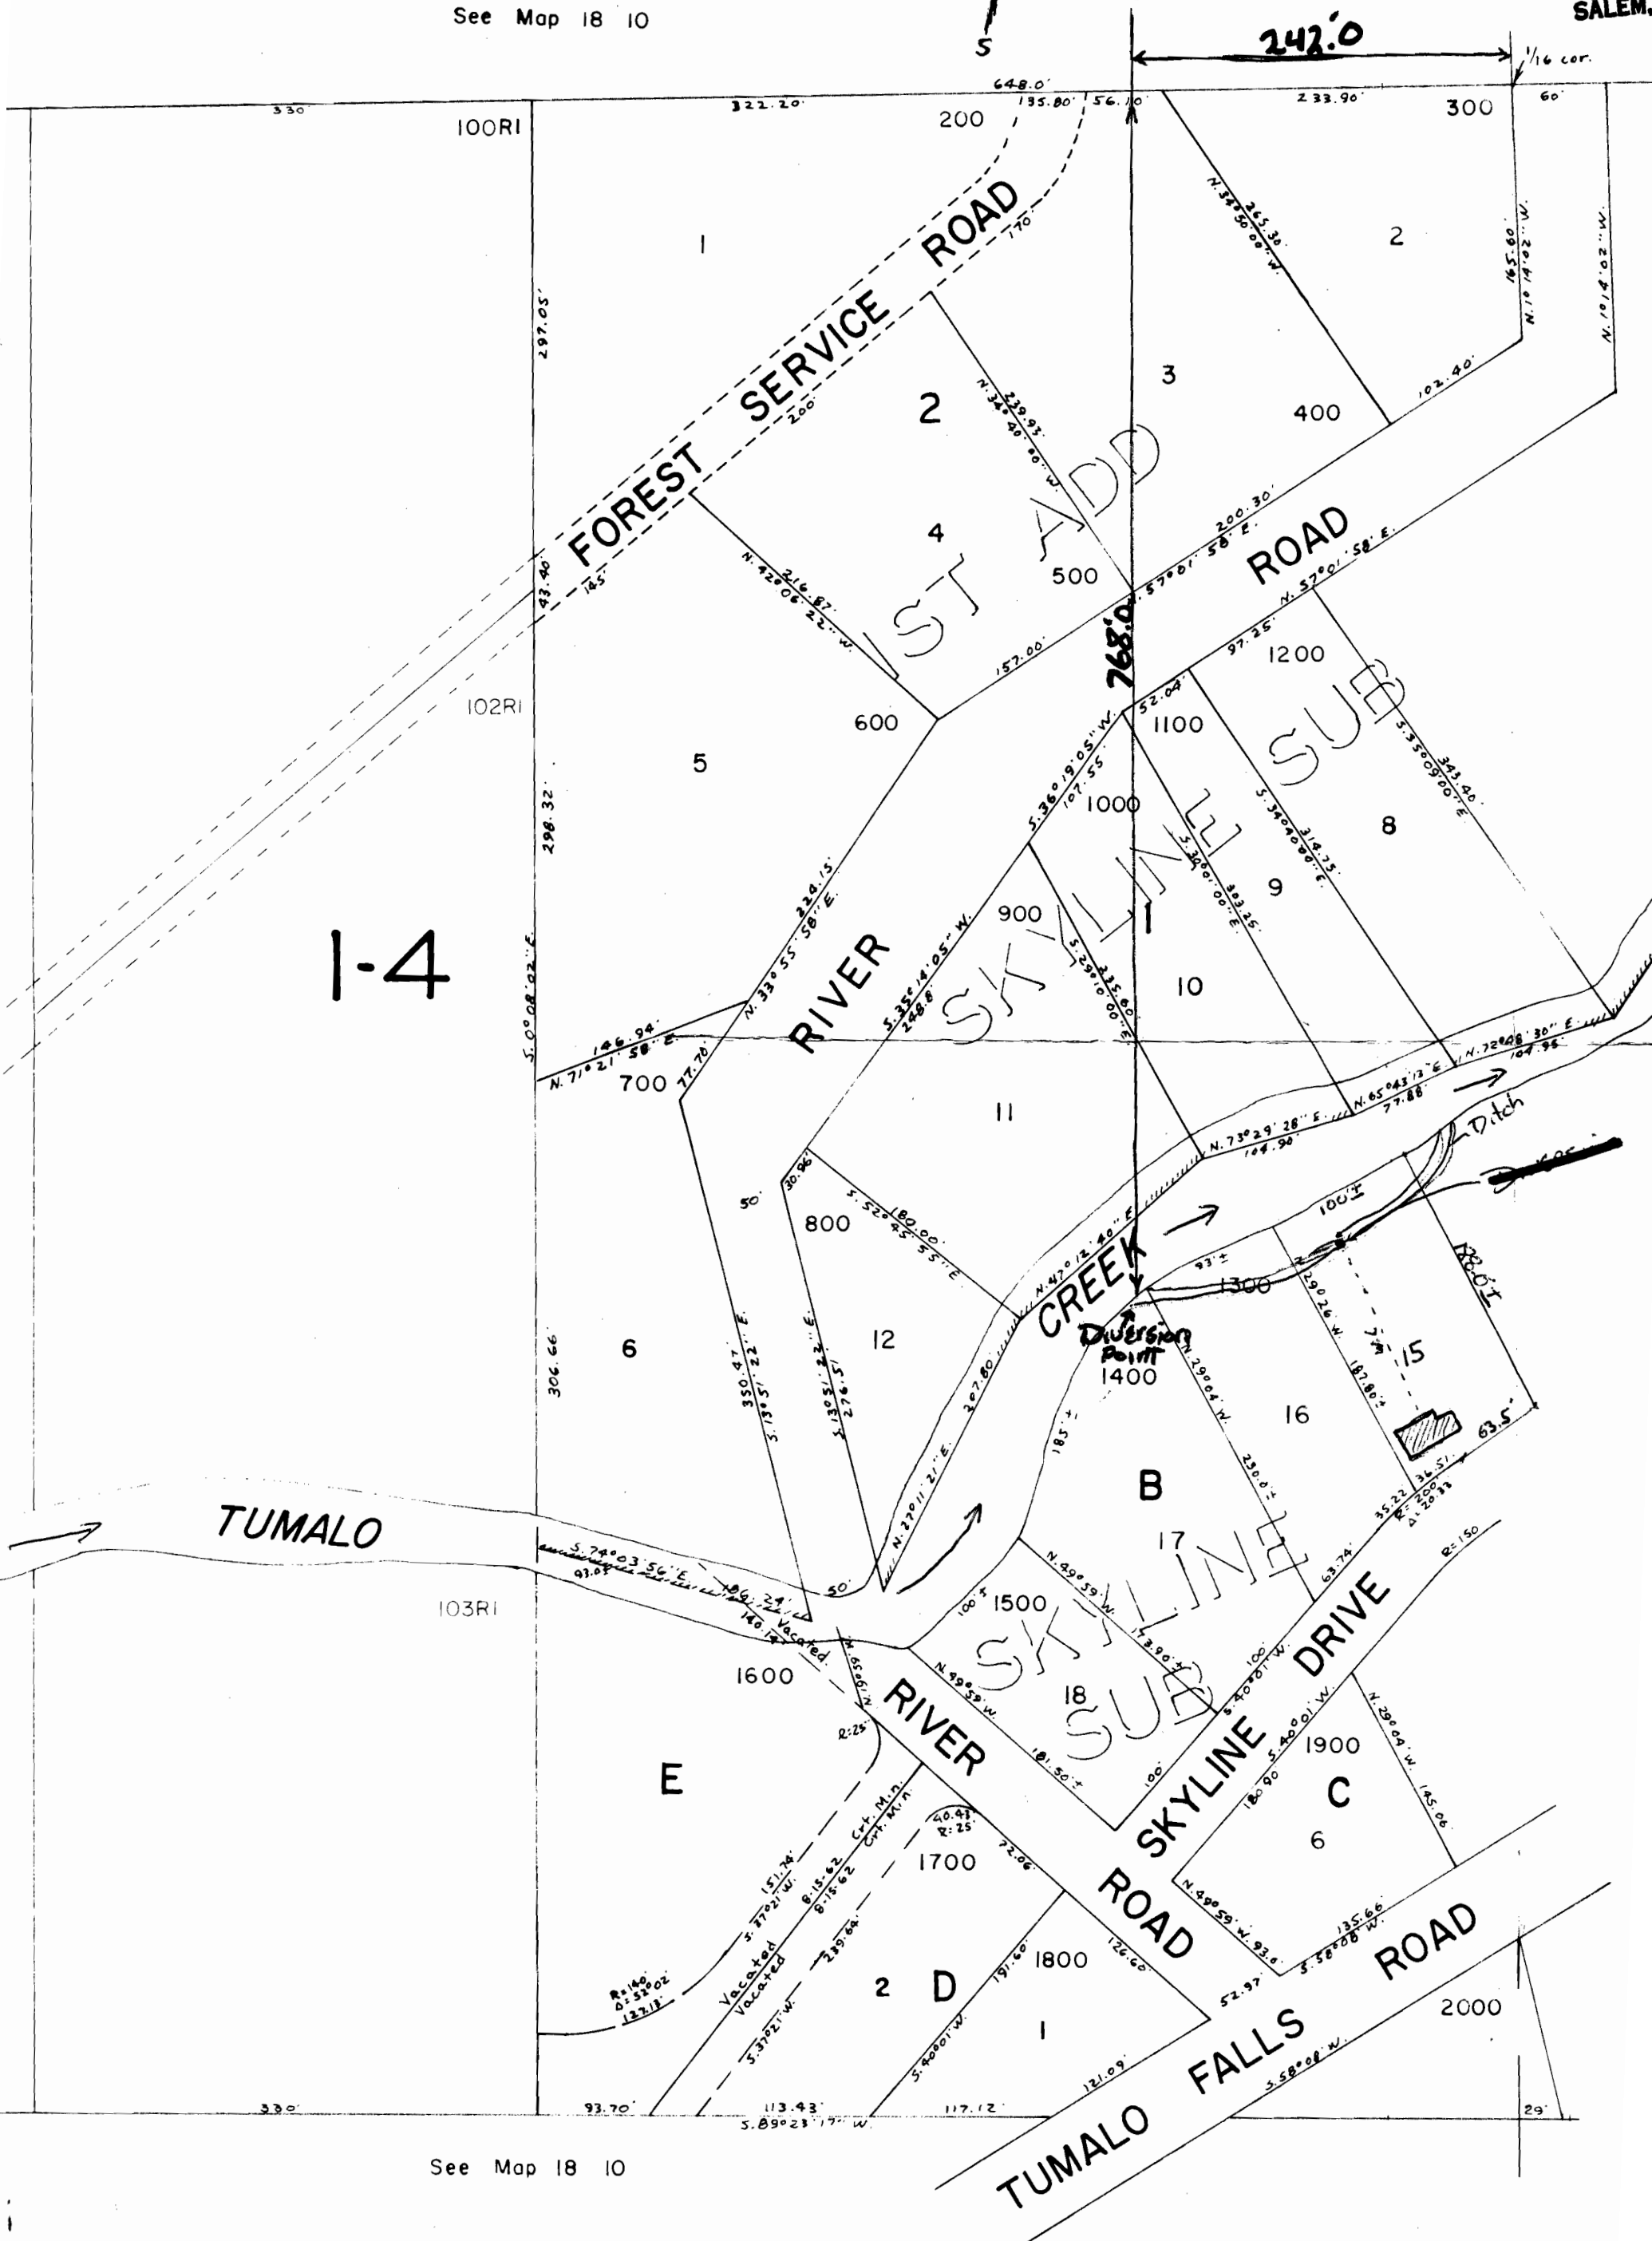

See Map 18 10