


T. 2 N., R. 3 W., W.M.

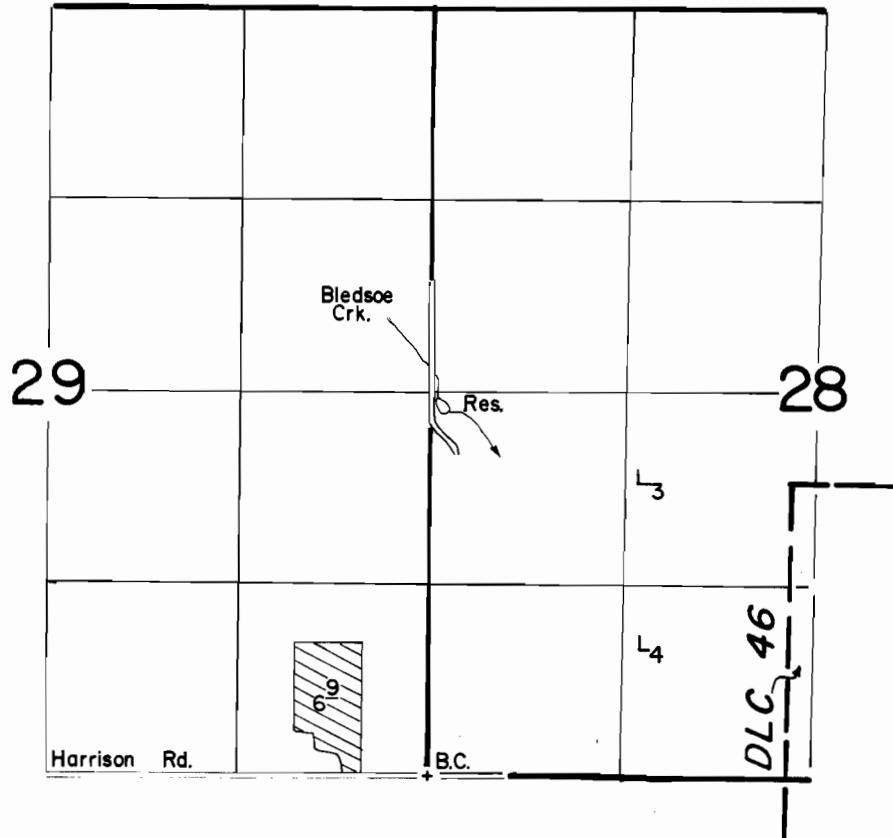

P.O.D. Loc. : 2500' N. & 100' E. from SW Cor. Sec. 28.

Scale : 1" = 1320'

FINAL PROOF SURVEY UNDER

R-63446

R-8494

Application No.63447 Permit No.46979....

IN NAME OF

JOHN E. SCHLEGEL

Surveyed JUNE 23 1987, by Ben Bishop
& AUG. 11 1988, by T. Warren