
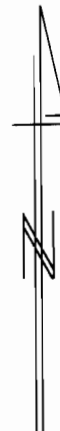


T 4 S, R 4 E, WM

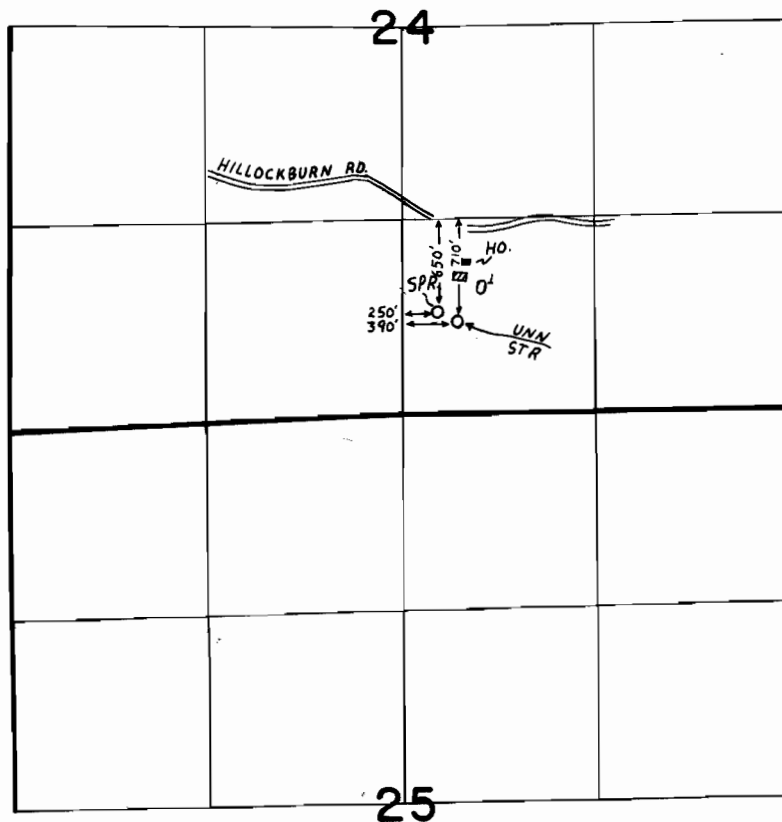

SCALE : 1" = 1320'

FINAL PROOF SURVEY UNDER

Application No. 64.97.7. Permit No. 47.720.....
IN NAME OF

DONALD E. & SHIRLEY A. BASHAM

Surveyed JUNE 18, 1987, by T.M. WARREN..