
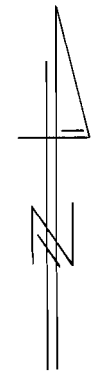


# T2S, R3E, WM SEC 1

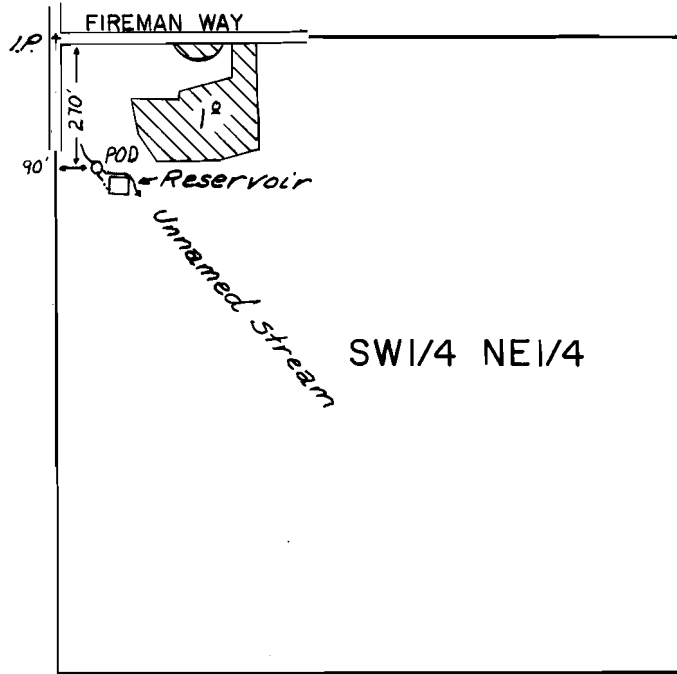

1" = 400'

*RESERVOIR LOCATED: 320 feet South and 150 feet East from NW Corner SW 1/4 NE 1/4, Section 1.*

## FINAL PROOF SURVEY UNDER

R-65617                      R-8993  
Application No. 65618 Permit No. 48009

IN NAME OF

KENNETH E. & DOROTHY D. NAAS

Surveyed JUNE 30 1987, by T.M. WARREN