


T. 23 S., R. 6 W., W. M.

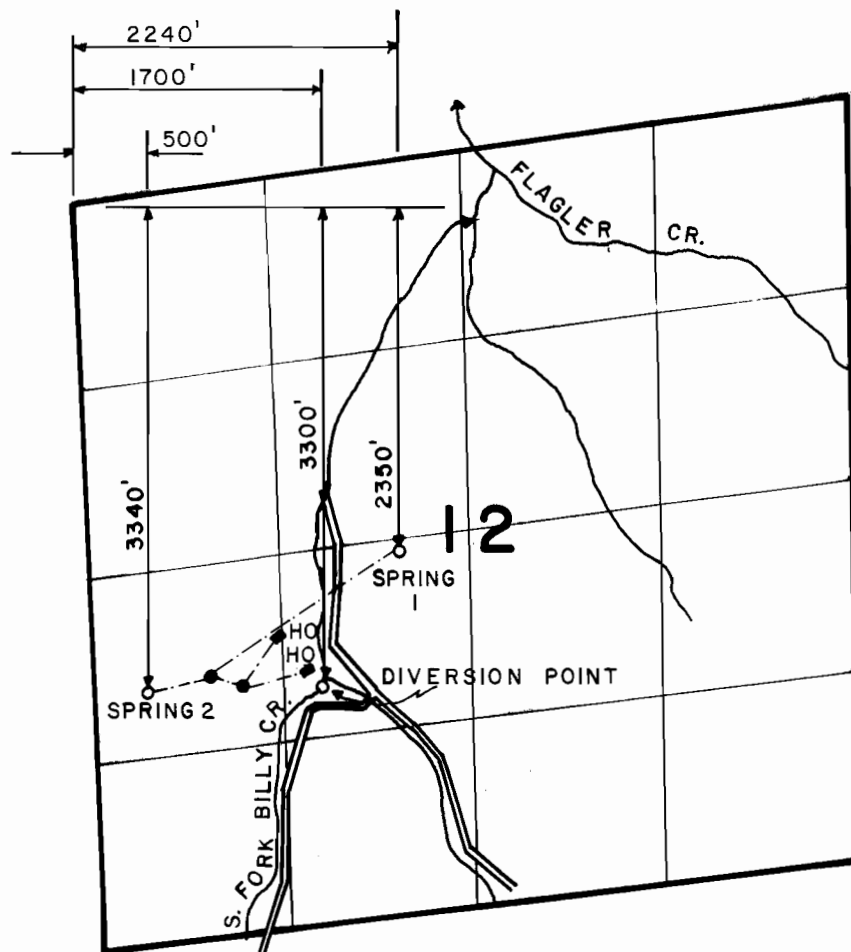

SCALE: 4" = 1 MILE

FINAL PROOF SURVEY UNDER

Application No. 68597... Permit No. 49618...
IN NAME OF

.....**HERSCHEL PHILLIPS**.....

Surveyed AUG. 2... 19.88, by J. M. SCHMORDE