

RECEIVED


JUN 4 1986

WATER RESOURCES DEPT
SALMON DIVISION
OREGON

POINT OF DIVERSION
N 724,400 E 2717,039
(LAMBERT COORD)
DOMESTIC WELL

Permit No. 68744
Permit No. 49961

POINT OF DIVERSION
N 723,756 - E 2,716,934
(LAMBERT COORD)

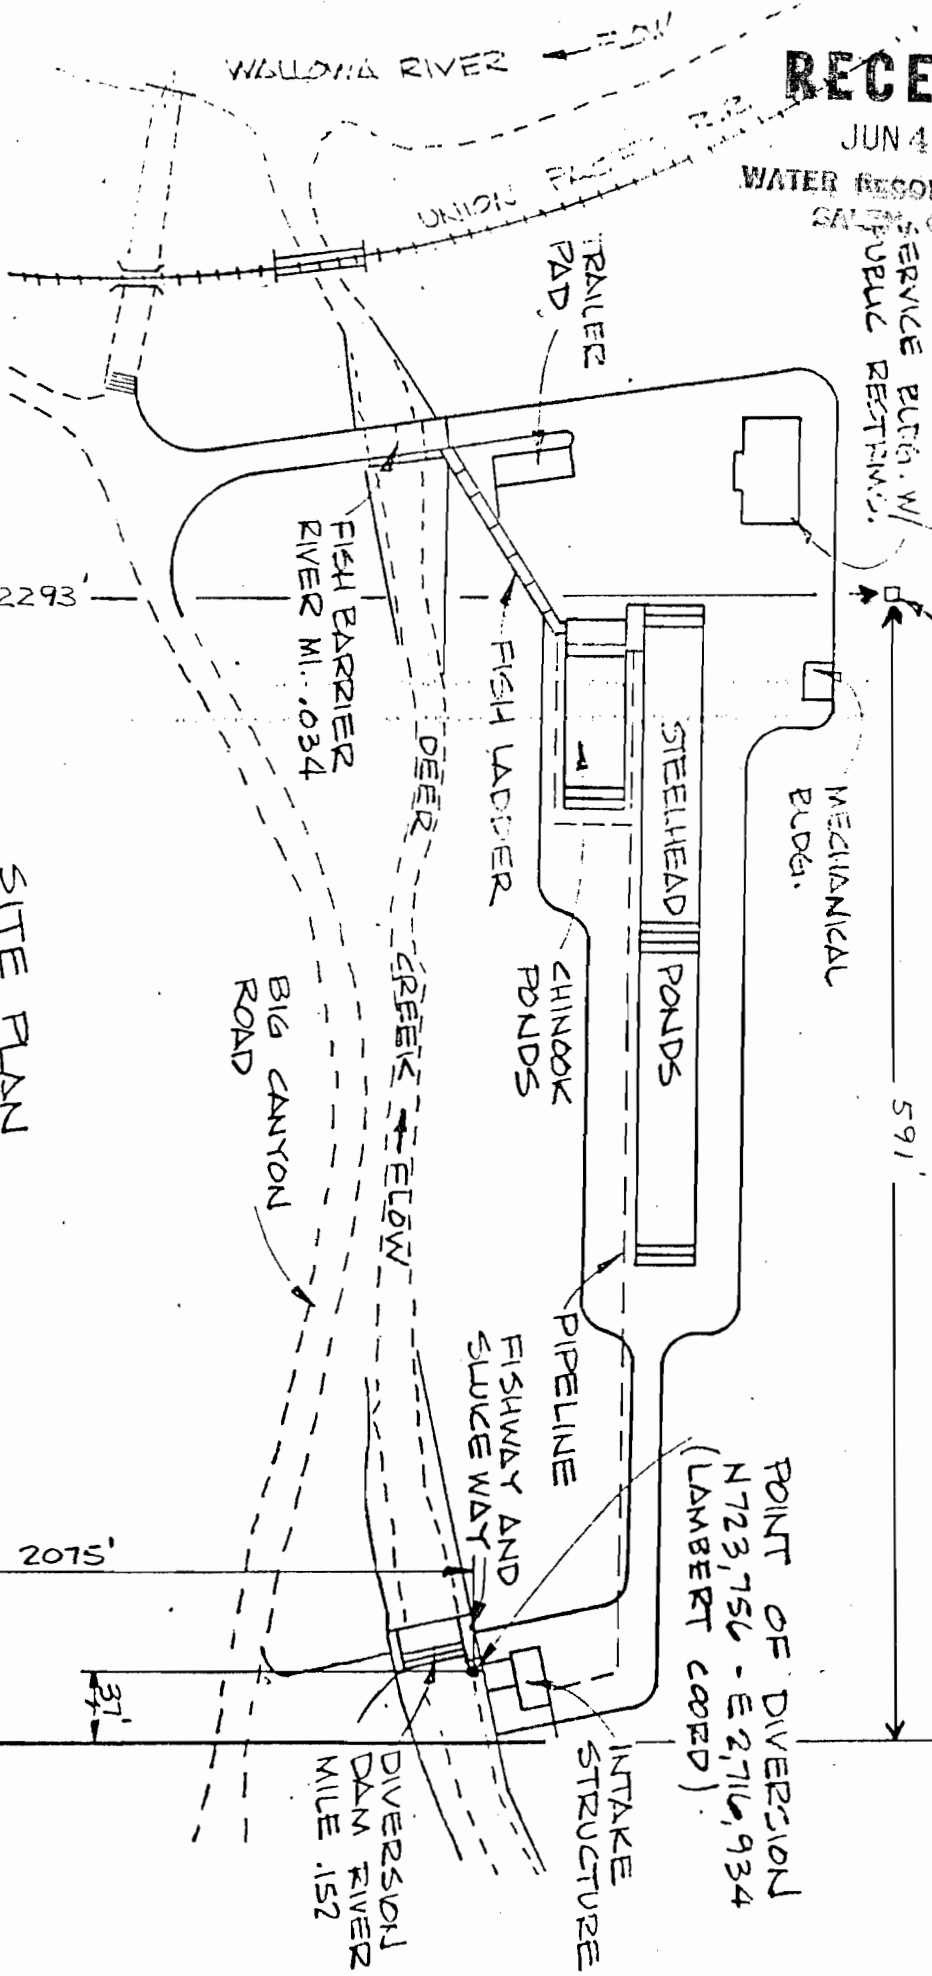

SITE PLAN

SCALE: 1"=100'

BIG CANYON FISH FACILITY
WATER RIGHTS APPLICATION

SW CORNER
T2N, R41E
SEC. 28