


T.5S.R.10W.W.M.

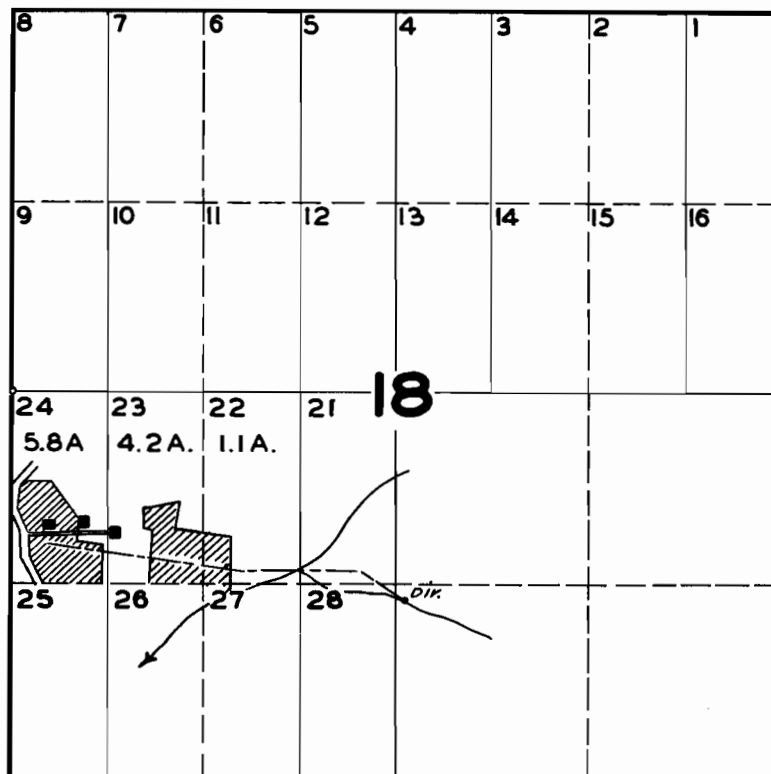

FINAL PROOF SURVEY
UNDER

Application No. **22768** Permit No. **17938**
IN NAME OF

REUBEN NASH

Surveyed **SEP. 7** 1948, by **JAS. E. BUNNELL**