


35

36

T.13 & 14 S. R. 31 & 32 E. W.M.

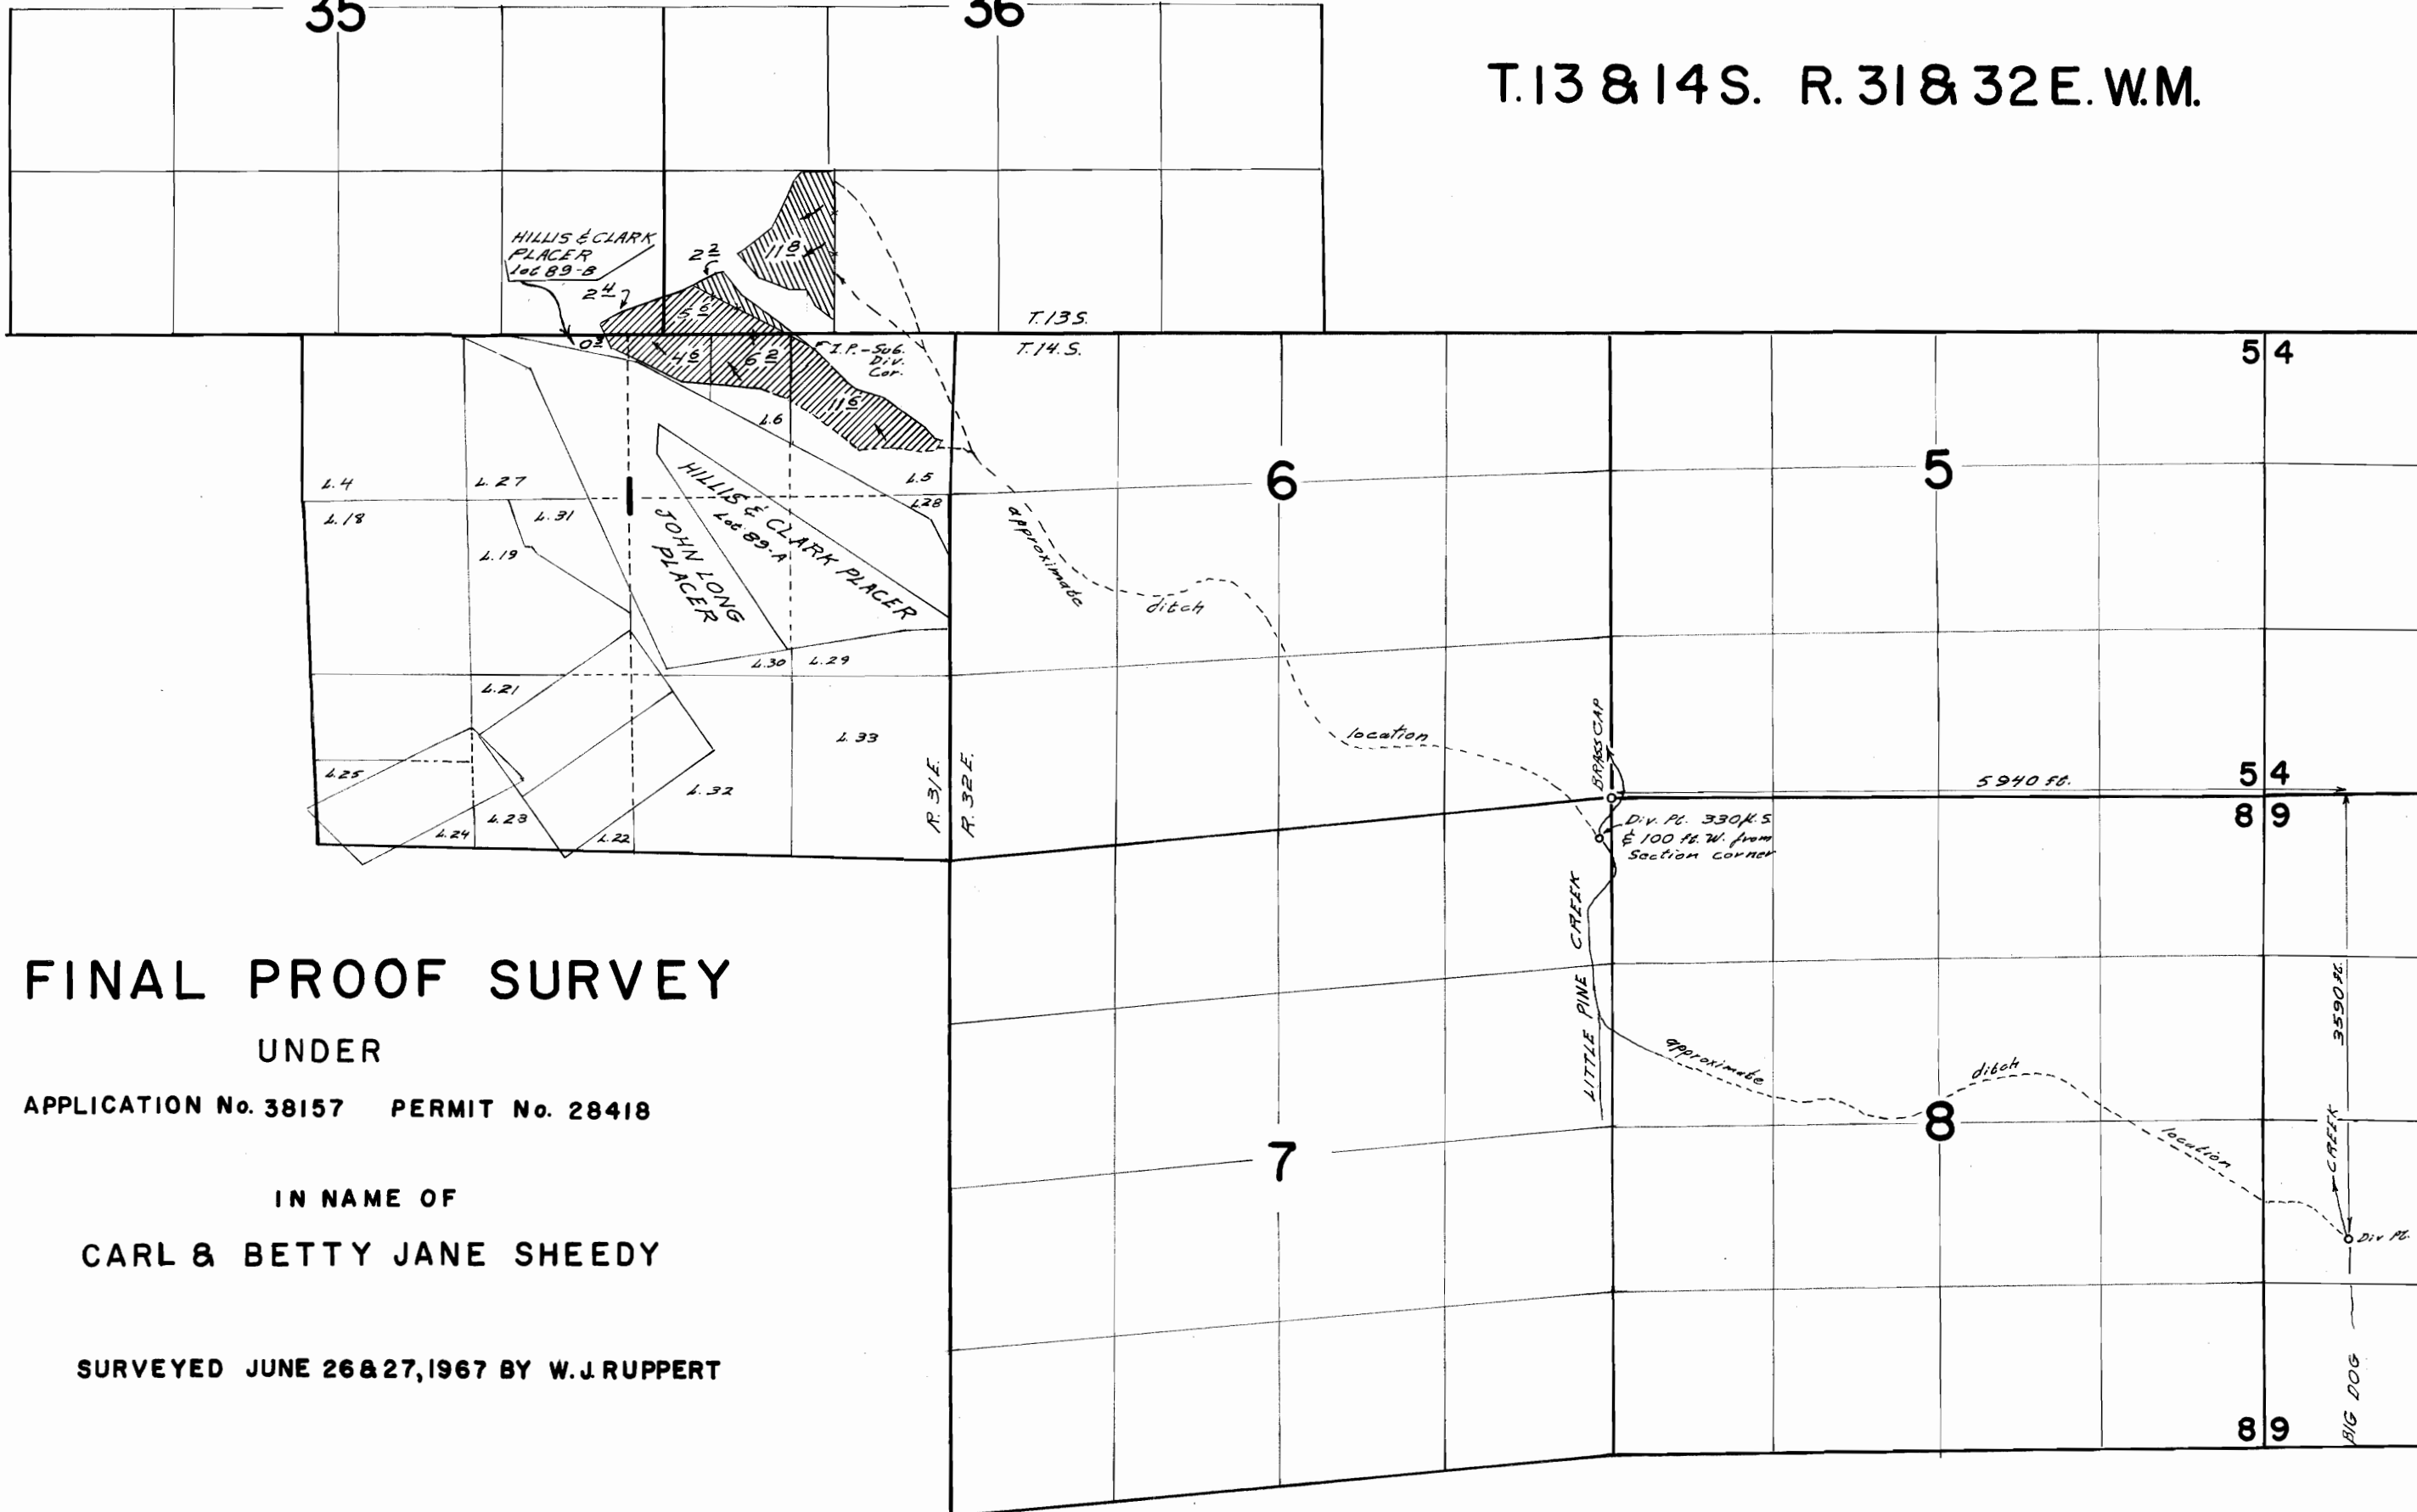

FINAL PROOF SURVEY

UNDER

APPLICATION No. 38157 PERMIT No. 28418

IN NAME OF

CARL & BETTY JANE SHEEDY

SURVEYED JUNE 26 & 27, 1967 BY W. J. RUPPERT