


T. 23S., R. 31E., W. M.

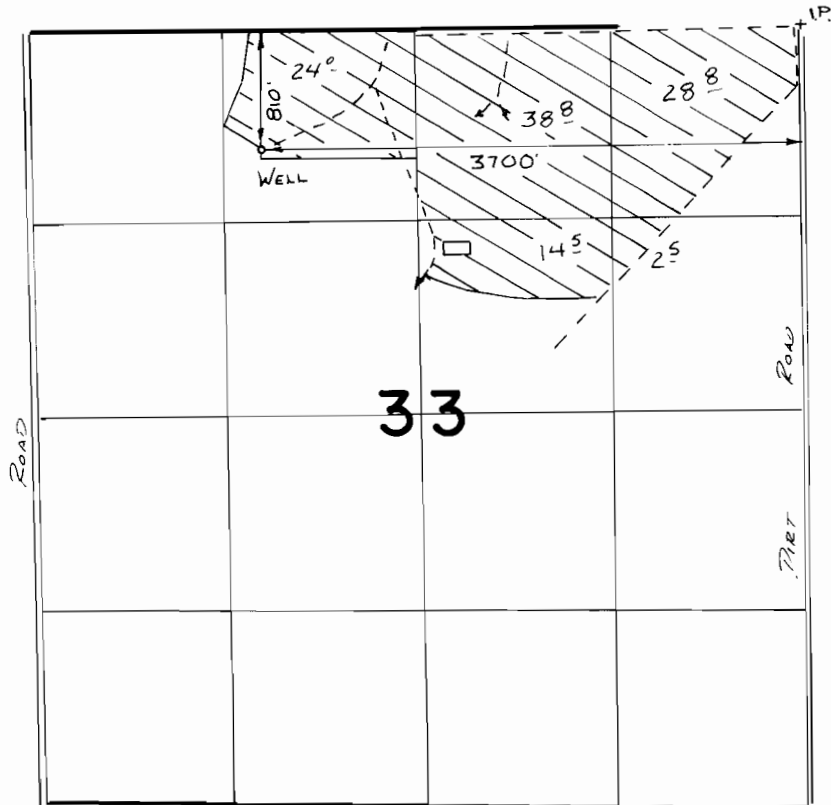

SCALE 1" = 1320'

FINAL PROOF SURVEY  
UNDER

Application No. **G-6443** Permit No. **G-6045**  
IN NAME OF

**LARRY D. WOODELL**

Surveyed **5-7** 19**88**, by **B.S. James**