


T. 35 S., R. 2 W., W. M.

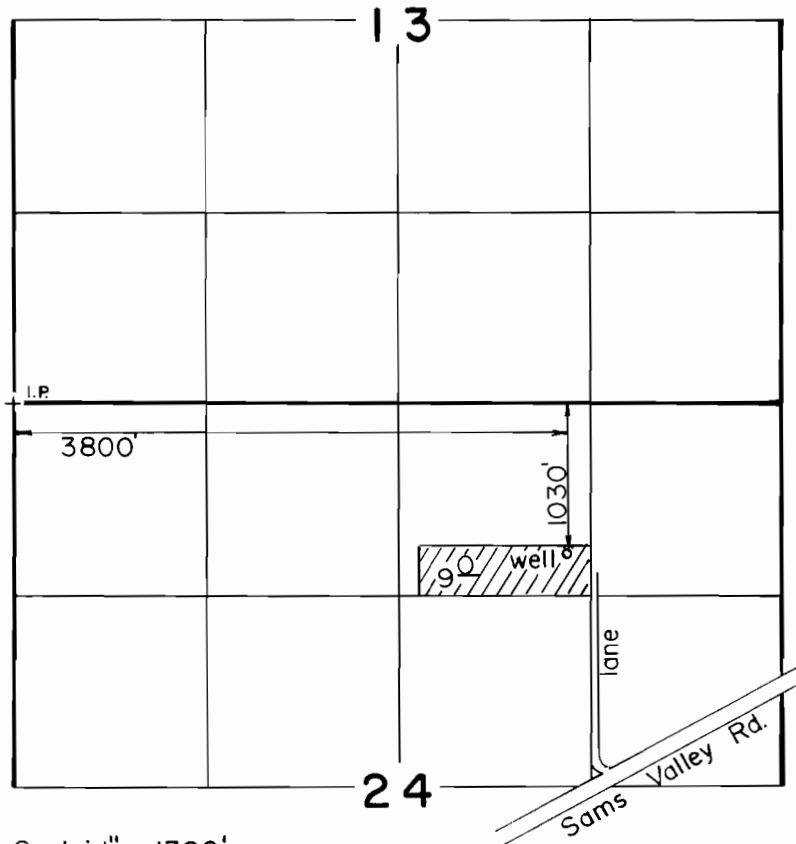

Scale: 1" = 1320'

FINAL PROOF SURVEY

UNDER

Application No. G-6474 Permit No. G-6098
IN NAME OF

DARRELL & WILMA BONNEY

Surveyed MAR. 31, 1988, by B. S. JAMES