



T.10S., R.39E., W.M.

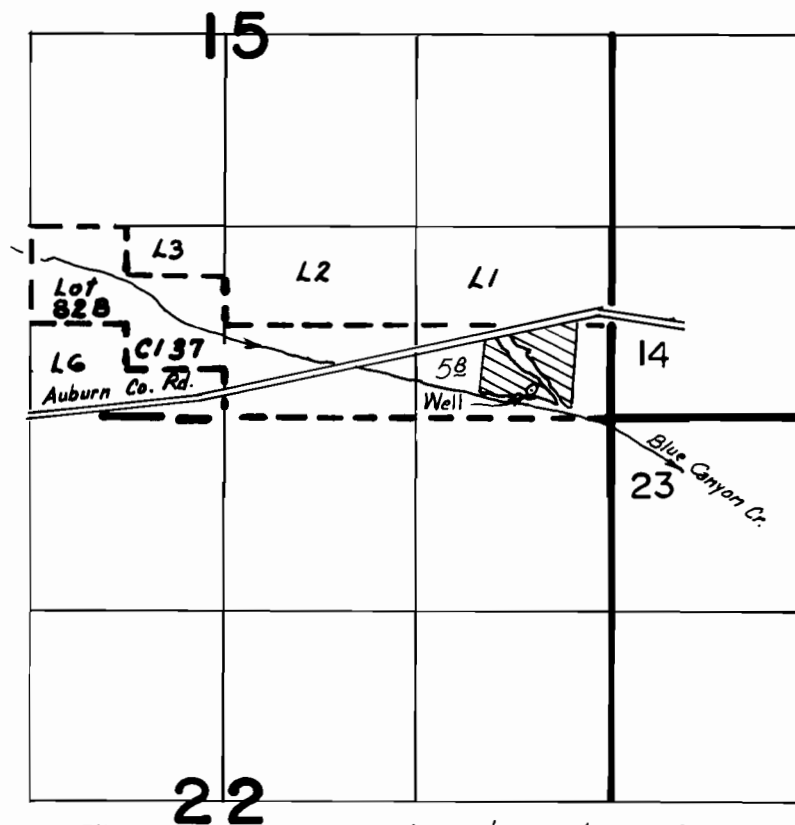

The well is located 180' N. & 540' W. from
SE cor. sec. 15.

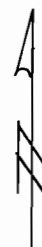

Scale: 1" = 1320'

FINAL PROOF SURVEY

UNDER

Application No. G6963 Permit No. G6475
IN NAME OF

A. W. TIEDMANN

Surveyed 10-2 1987, by Vern Church