


T. 37 S., R. 2 W., W.M.



STERNS WAY

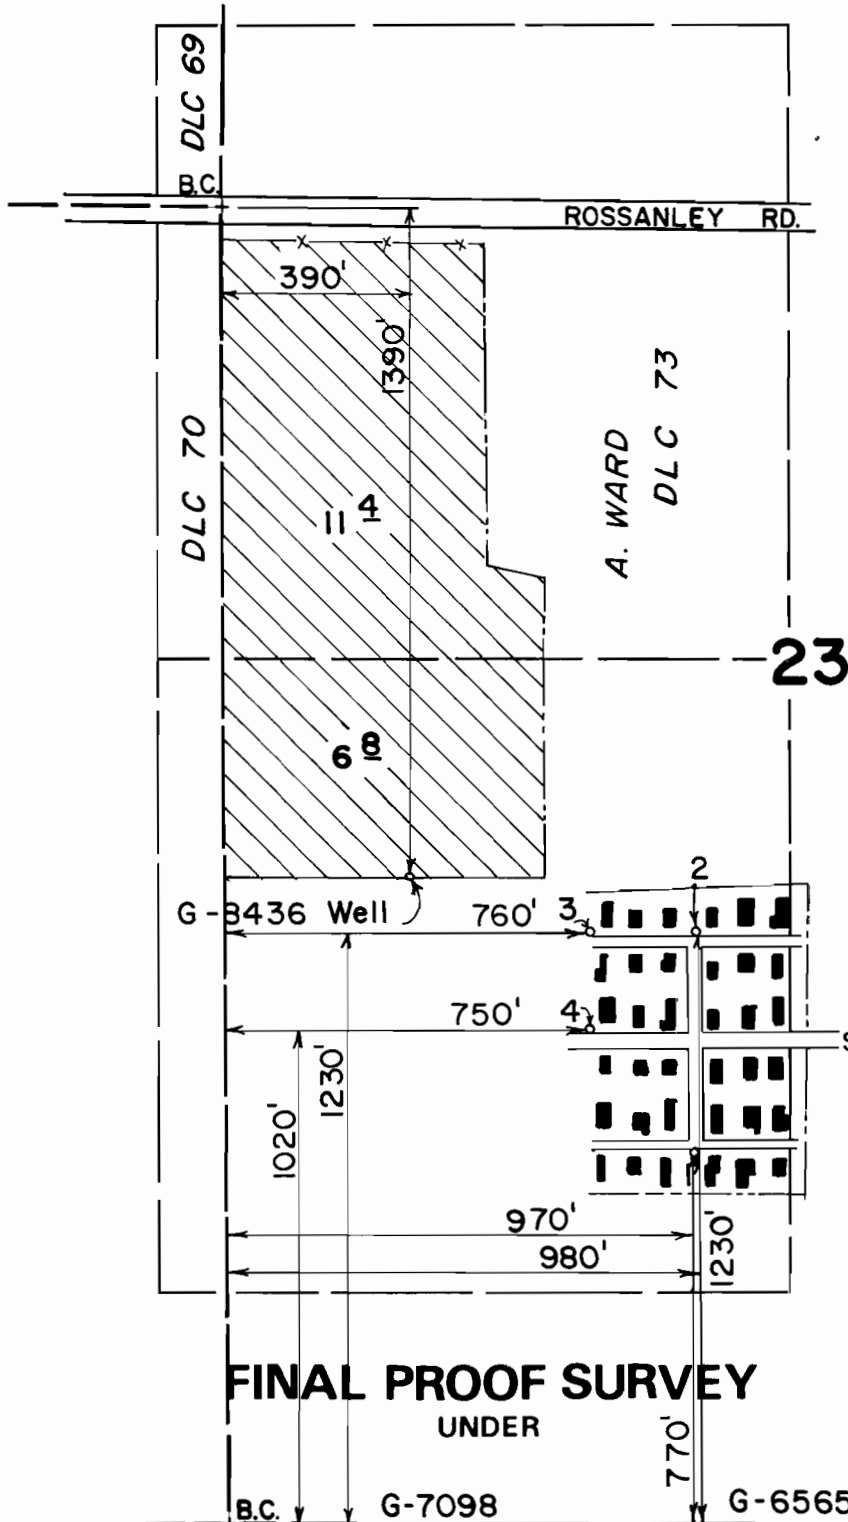

Scale 1" = 400'

FINAL PROOF SURVEY UNDER

B.C. G-7098 G-6565
 Application No. G-9004 Permit No. G-8436
 IN NAME OF

JOE E. & FRANCES M. BROOKS

Surveyed Aug. 11, 1988, by B.S. JAMES

BSJ