

# FINAL PROOF SURVEY

UNDER

## T. 23S., R. 26 & 27E., W. M


APPL. G-7224  
G-7225  
G-7229  
G-7227  
G-8339  
G-7228  
G-7226

PER. G-6882  
G-6883  
G-6887  
G-6885  
G-7765  
G-6686  
G-6884

IN NAME OF


**GALEN & PATRICIA HOOVER**

Surveyed May 10 1988, by B.W. Bishop

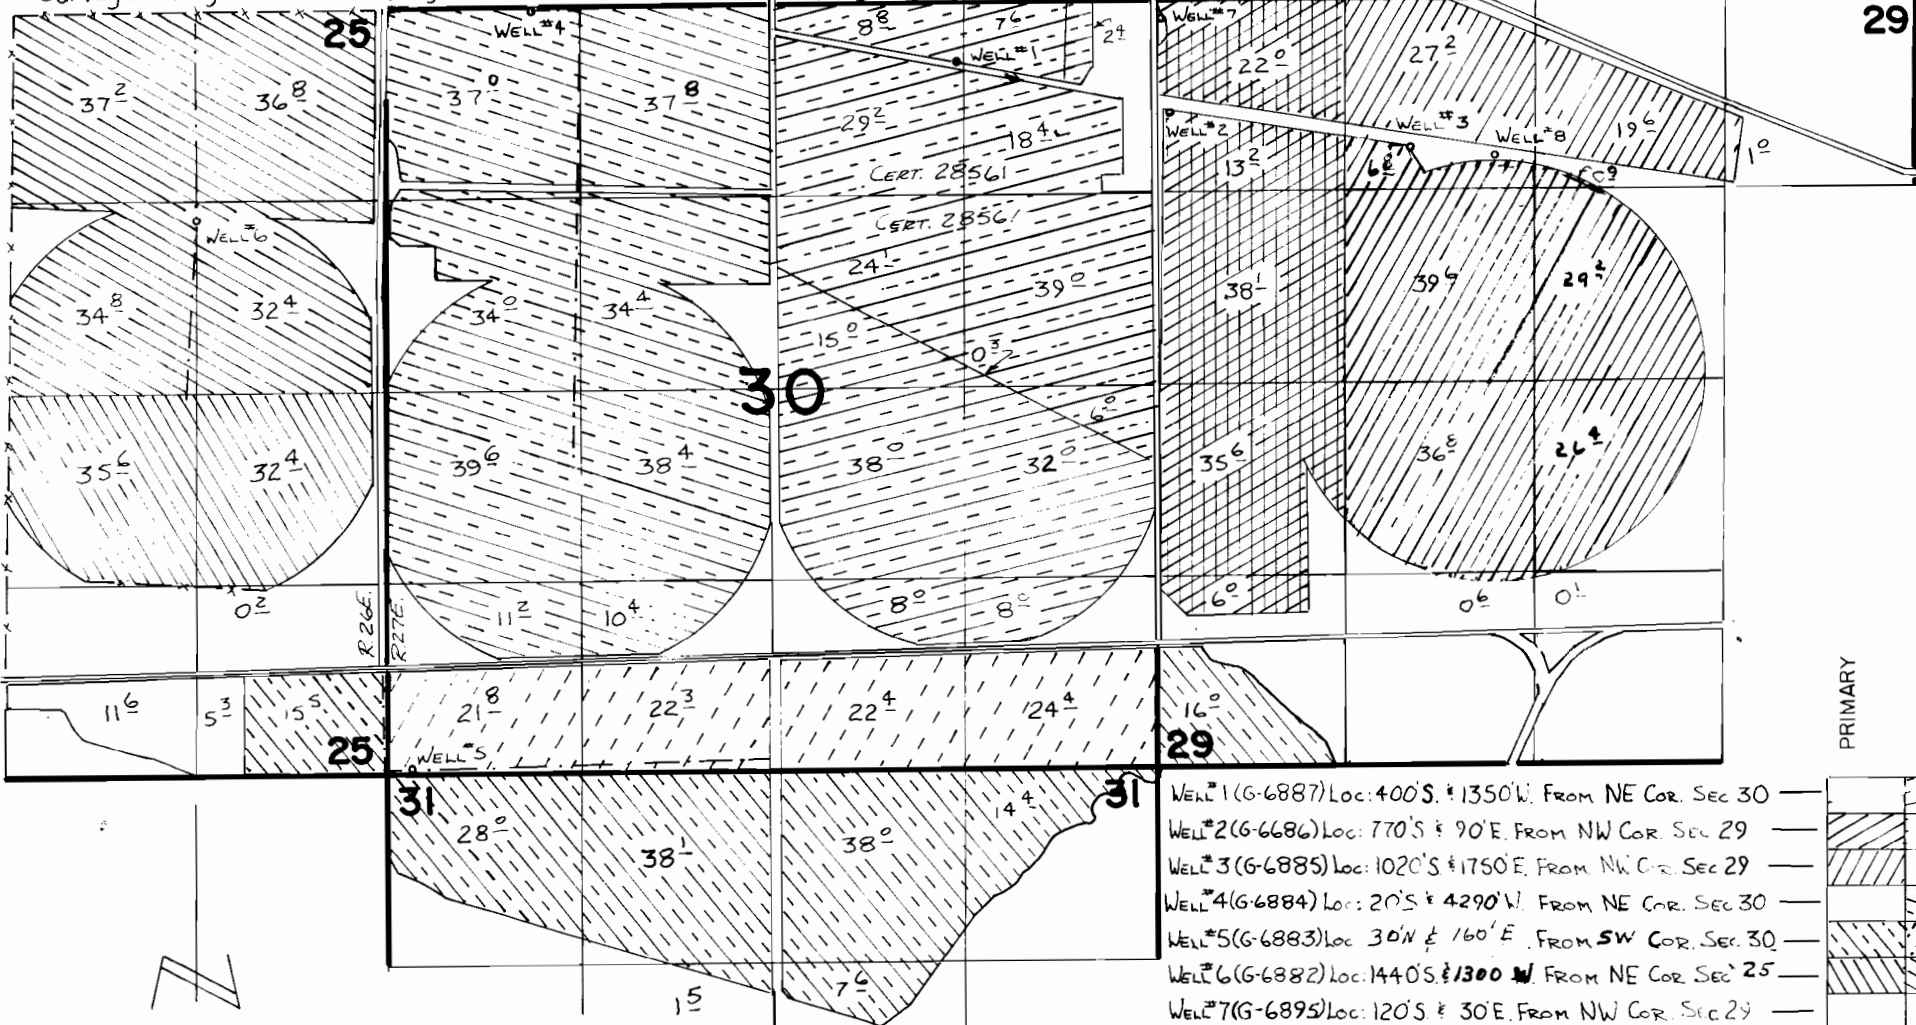

SCALE 1" = 1320'

- WELL #7 (G-6895) Loc: 120°S & 30°E. FROM NW COR. SEC 29
- WELL #8 (G-7765) Loc: 109°S & 234°E. FROM NW COR. SEC 29

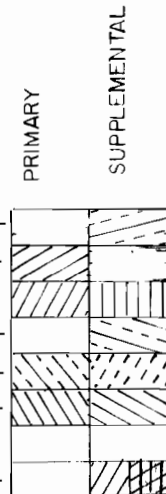

90884  
88-82-1102M  
4025-279-444