


T.16S., R.16E., W.M.

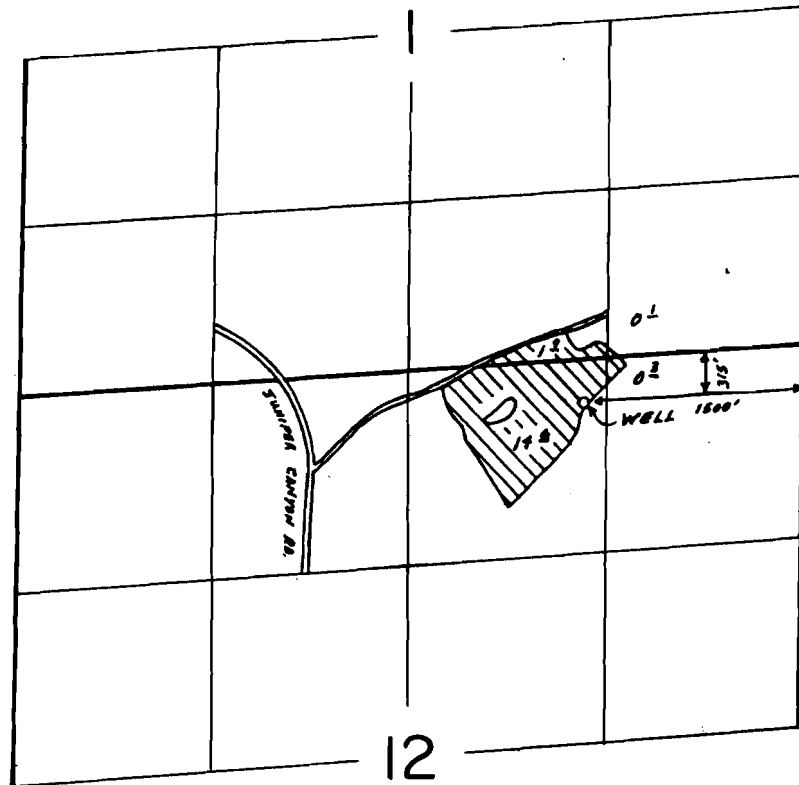

SCALE: 1"=1320'

FINAL PROOF SURVEY
UNDER

Application No. G-7390 Permit No. G-6904 Cert. # 61073
IN NAME OF

G. T. DUFFY

Surveyed JUN. 13, 1988, by B. BISHOP

RECEIVED

DATE 5-23-89

WATER MASTER DISTRICT #11

BY *mg*