


# T. 39 S., R. 3 W., W. M.

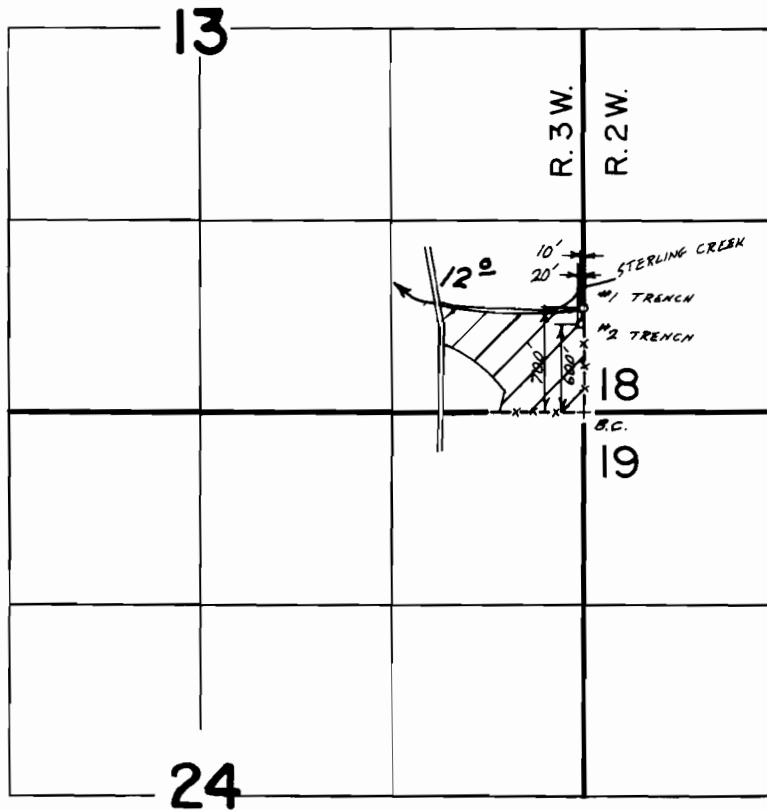

Scale 1"=1320'

## FINAL PROOF SURVEY UNDER

Application No. G-7417... Permit No. G-6921....  
IN NAME OF

..... P. F. HOLT .....

Surveyed Nov. 23, 1987., by B.S. JAMES.....