
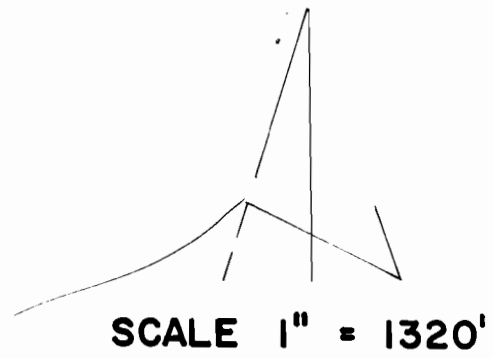


# T. 25S., R. 34E., W.M.

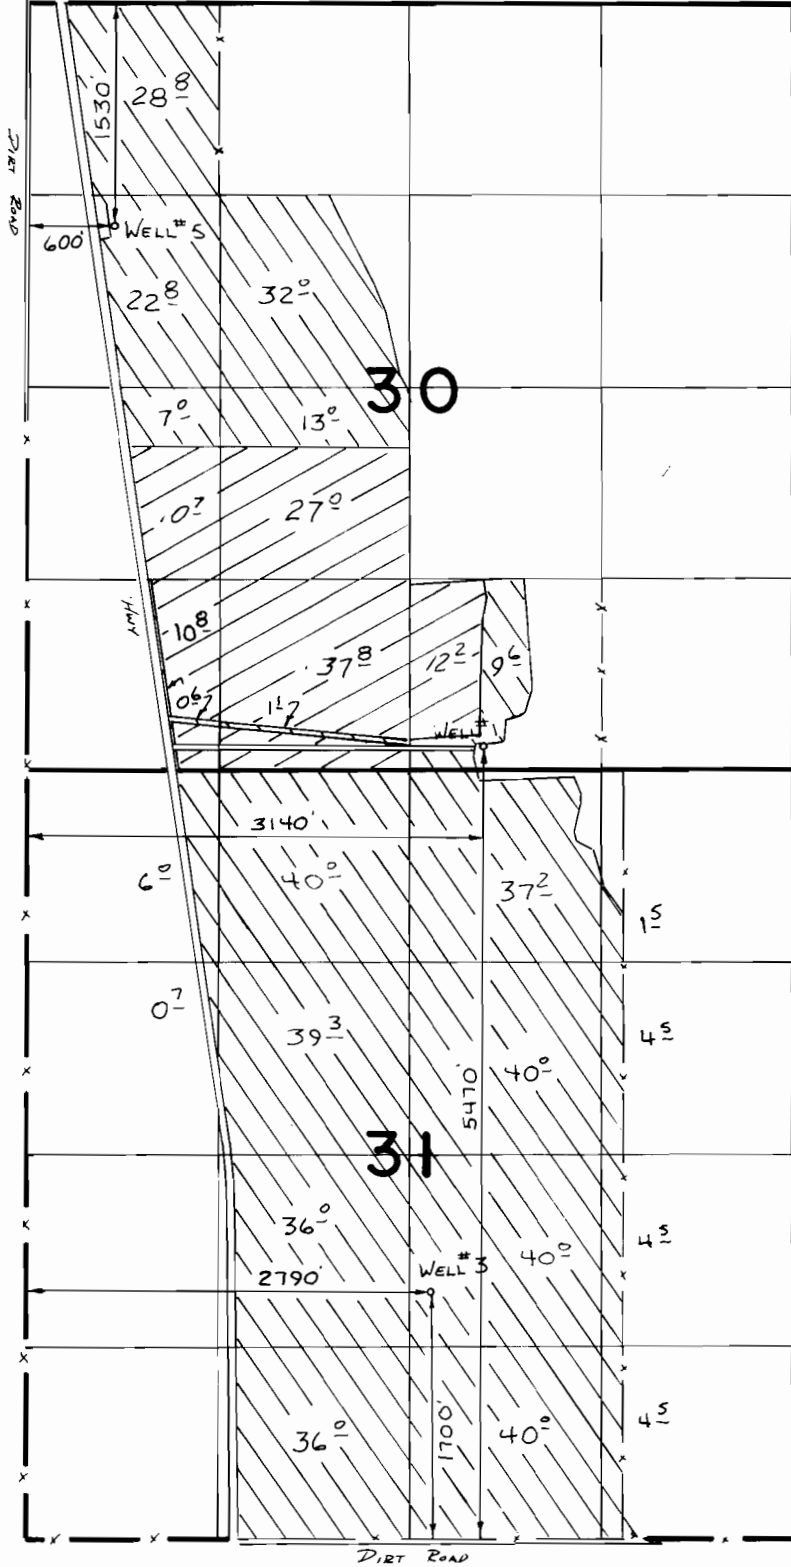

 PRIM. WELLS # 1, 3, 5     
  SUPPL. WELLS # 3, 5

## FINAL PROOF SURVEY UNDER

APPL. G-8621      PER. G-8161  
 IN NAME OF  
 RED CINDER, INC.

Surveyed MAY 5, 1988, by V. CHURCH