


T. 26S., R. 33E., W.M.

Scale 1" = 1320'

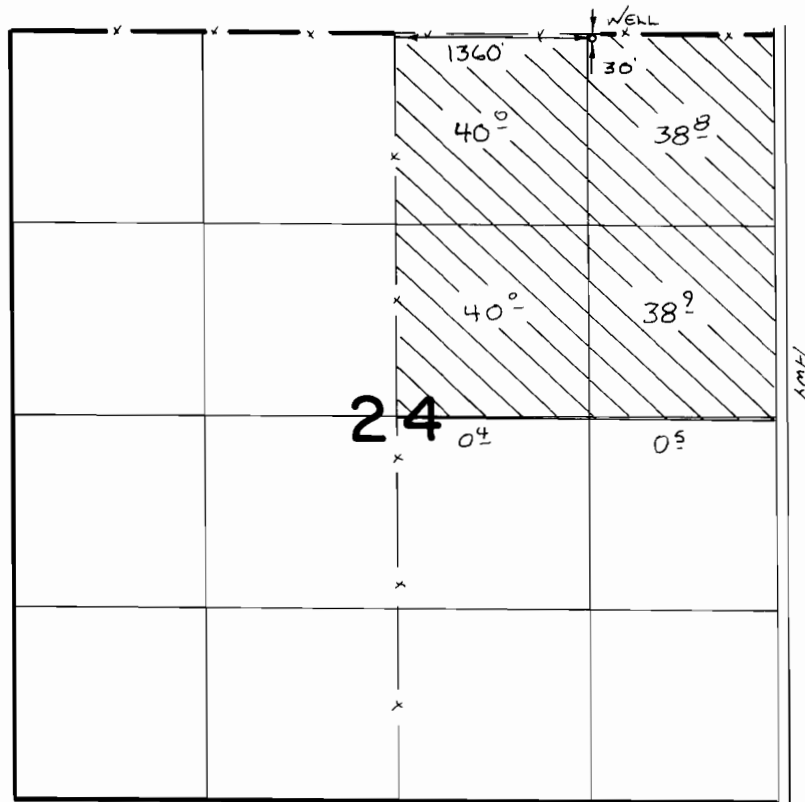

FINAL PROOF SURVEY
UNDER

Application No. **G:8622** Permit No. **G:8162**...
IN NAME OF

CINDER BUTTE INC.

Surveyed **5-10-1988**, by **V.L. Church**