
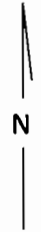


T. 39 S., R. 7 W., W.M.

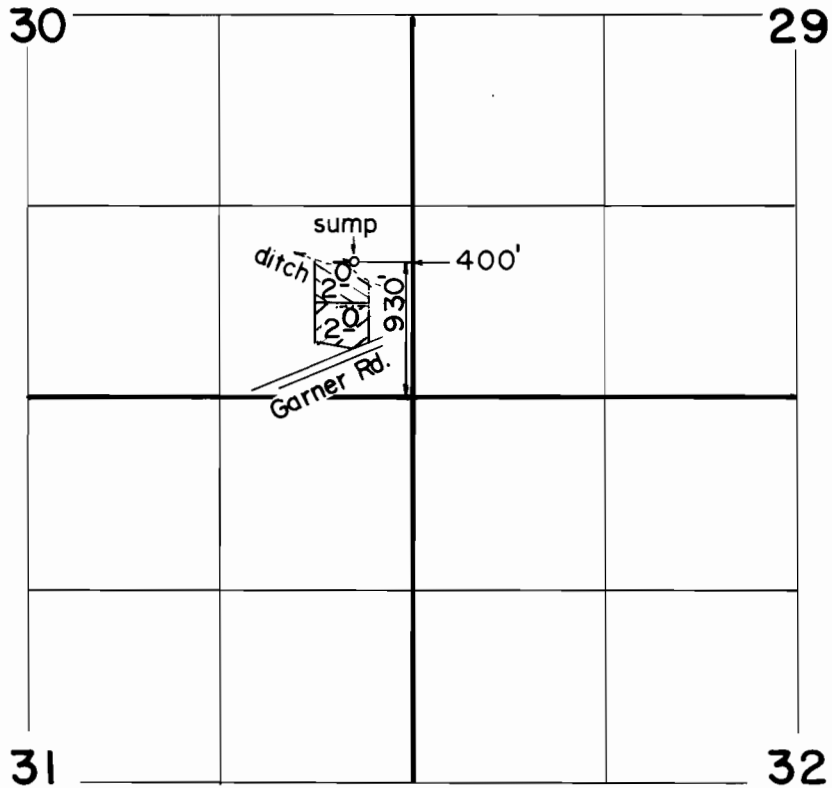

Scale: 1" = 1320'

Ditch Div. Pt.:
 1600' N., 1650' W., from SE cor. Sec. 29, T. 39S., R. 7W.

- 5294
- G-8885

FINAL PROOF SURVEY UNDER

TRANSFER NO. 5294
 Application No. G-9425 Permit No. G-8885
 IN NAME OF
CLIFFORD WOODS
 Surveyed MAY 12 1986, by B. S. JAMES