


T.8S.,R.46E.,W.M.

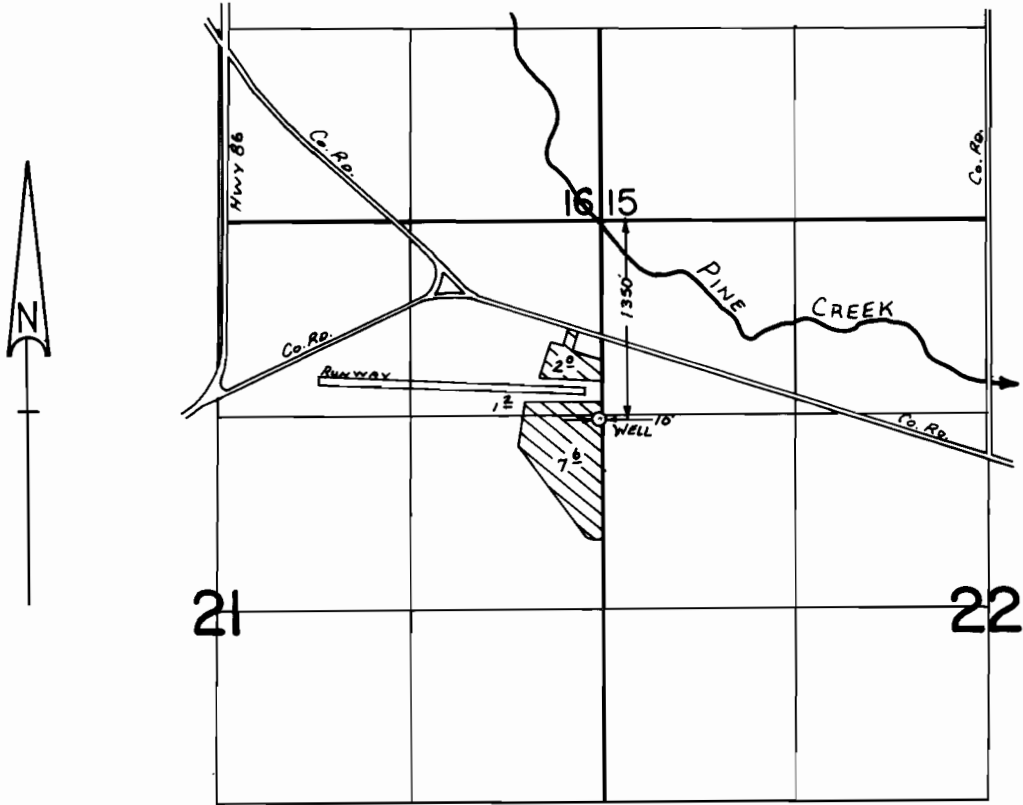

SCALE: 1" = 1320'

**FINAL PROOF SURVEY**  
UNDER

Application No. G:9444 Permit No. G:8870....

IN NAME OF

.....DONALD B. MARTIN.....

Surveyed Aug. 26, 1985, by L. M. TOLL.....