


T.8S.,R.2W.,W.M.

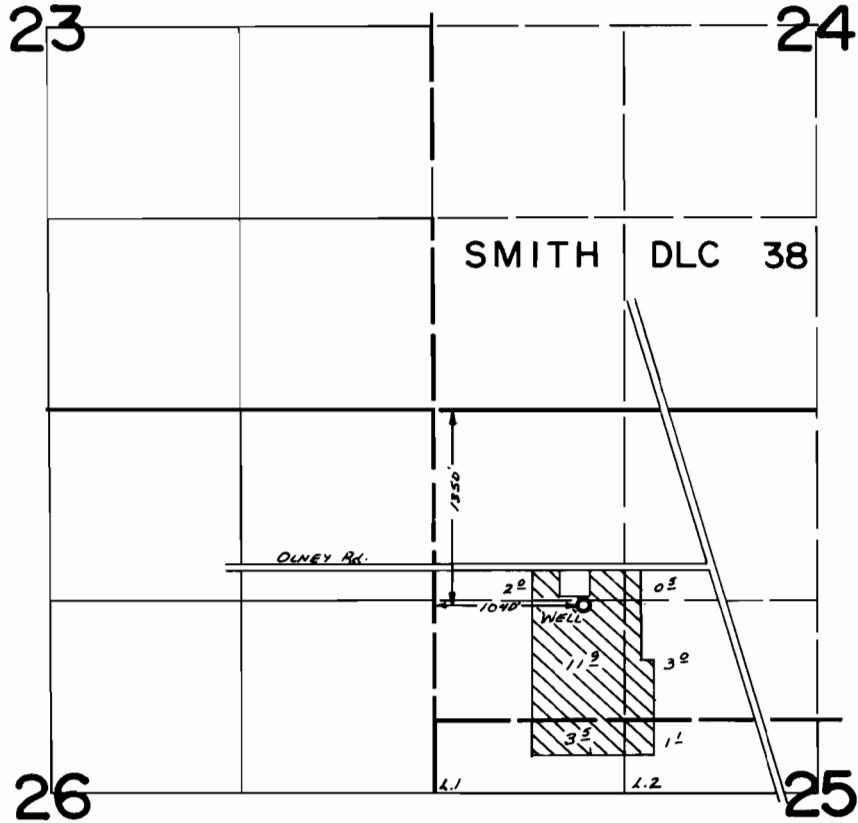

FINAL PROOF SURVEY
UNDER

Application No. G:9451. Permit No. G:8860....
IN NAME OF

.....**WENDELL BREWTON**.....

Surveyed Aug...12.. 19.81., by ..L..TOLL.....