


# T.8S.,R.2W.,W.M

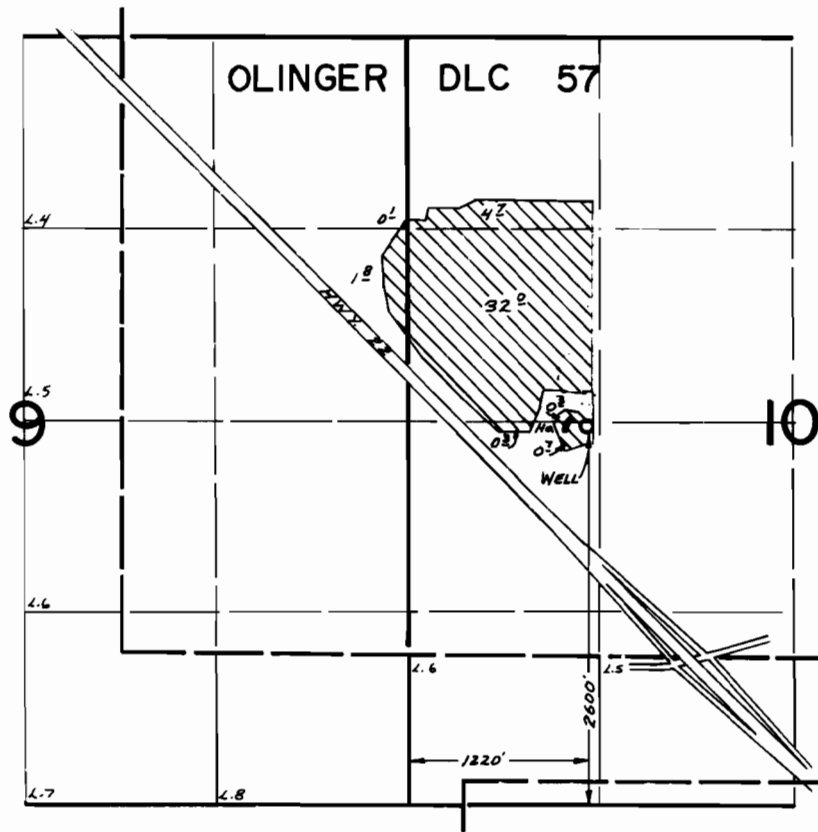

## FINAL PROOF SURVEY UNDER

Application No. G-9461 Permit No. G-8890.....  
IN NAME OF

DENNIS D. & CLAUDETTE J. FRANK

Surveyed Aug. 12, 1981, by L. TOLL.....