


T. 6 & 7S., R. 2W., WM

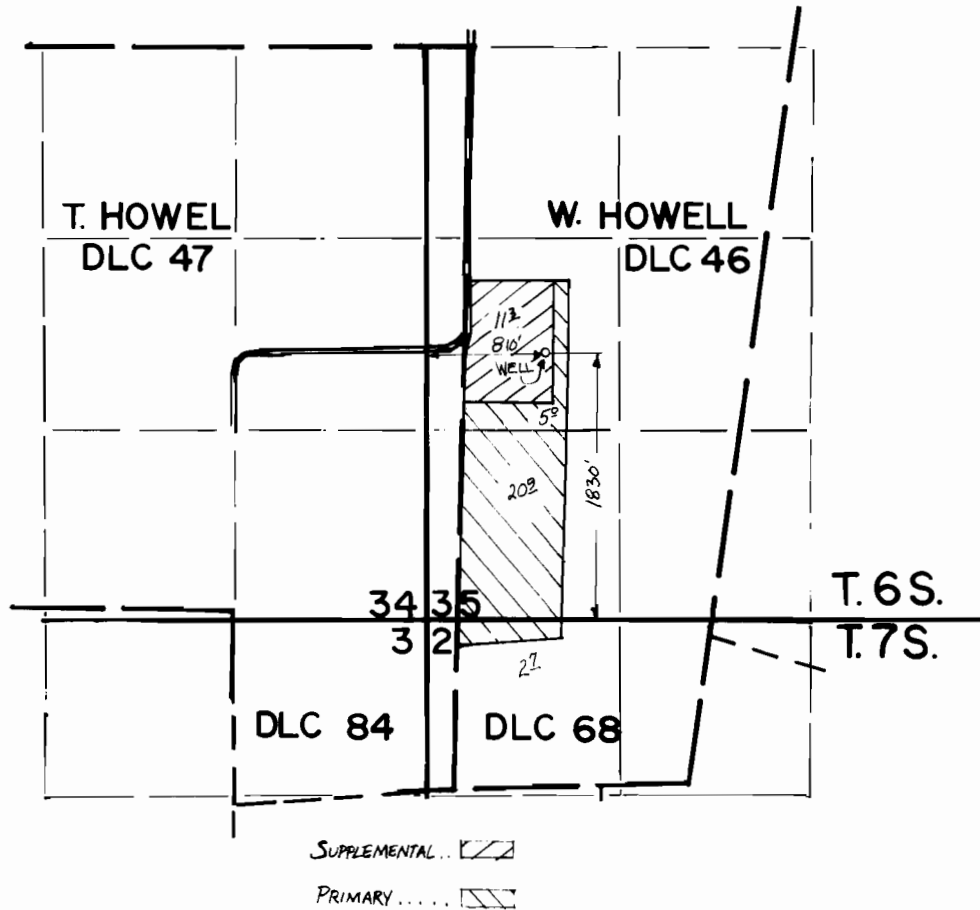

FINAL PROOF SURVEY UNDER

Application No. **G.9475** Permit No. **G.8862..**
IN NAME OF

SAM A. DETTWYLER

Surveyed **OCT. 27, 1983**, by **M. CAHILL**