


T. 2S., R. 38E., W. M.

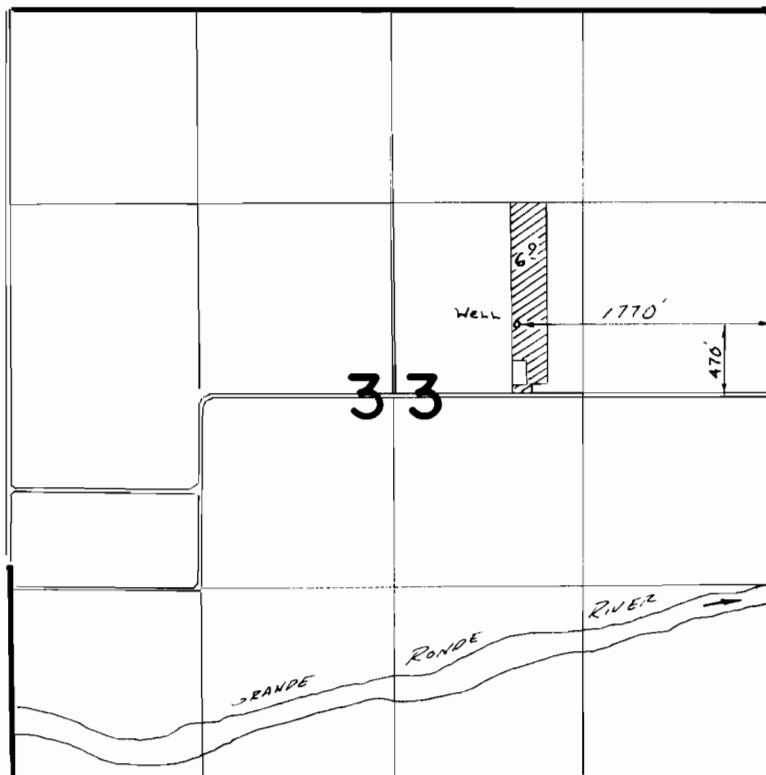

FINAL PROOF SURVEY
UNDER

Application No. **G-9488** Permit No. **G-8804**
IN NAME OF

GENE L. & SHIRLEY L. BOLIN

Surveyed *Aug. 24* 19*83*, by *J. L. Cluskey*