


T.11S., R.5W., W.M.

Section 10

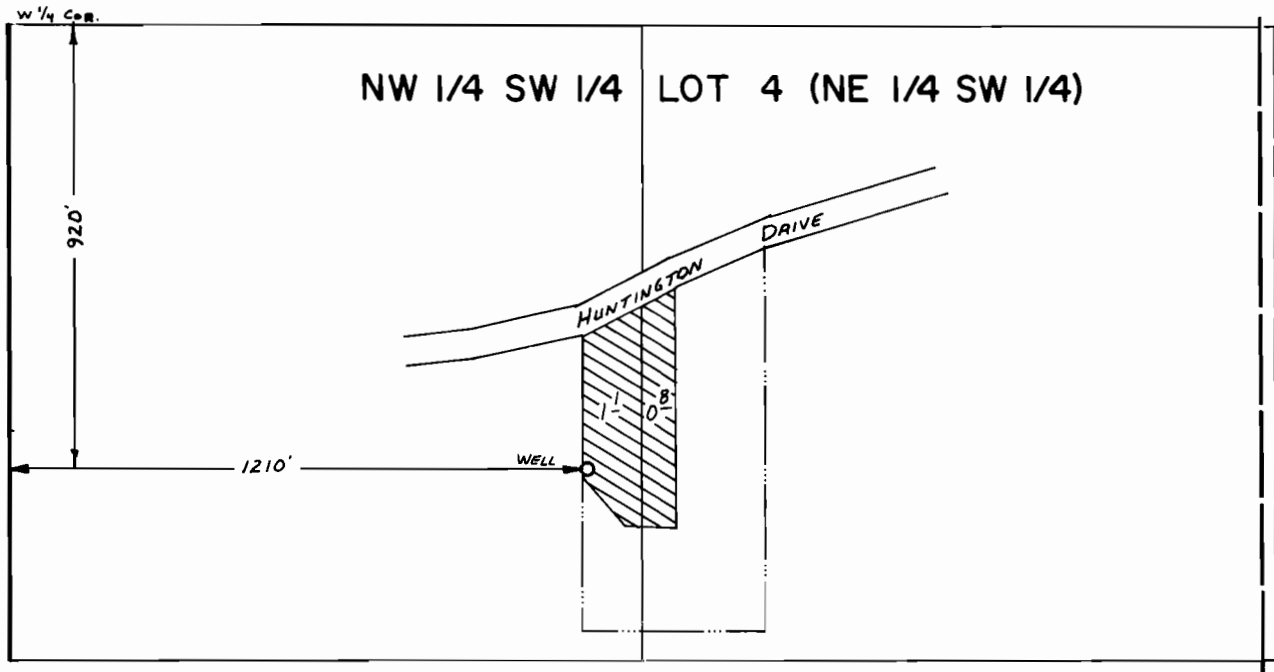

SCALE: 1" = 400'

FINAL PROOF SURVEY
UNDER

Application No. ...G-9495 Permit No. ...G-8893....
IN NAME OF

...BARBARA SNOOK CAMERON...

Surveyed Aug...31.. 19.82., by ...L.M. TOLL.....