


G 9865
61092

CANCELLED
Y49 P118

T-1091

T. 6N., R. 34E., W. M.

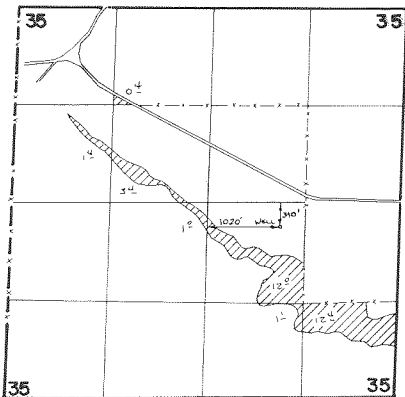

SCALE 1" = 1320'

FINAL PROOF SURVEY
UNDER

Application No. G:9496 Permit No. G:9865
IN NAME OF

ADOLF C. KLEIN

Surveyed ... 1987, by V. b. Church