


T. 5 & 6 N., R. 34 E., W. M.

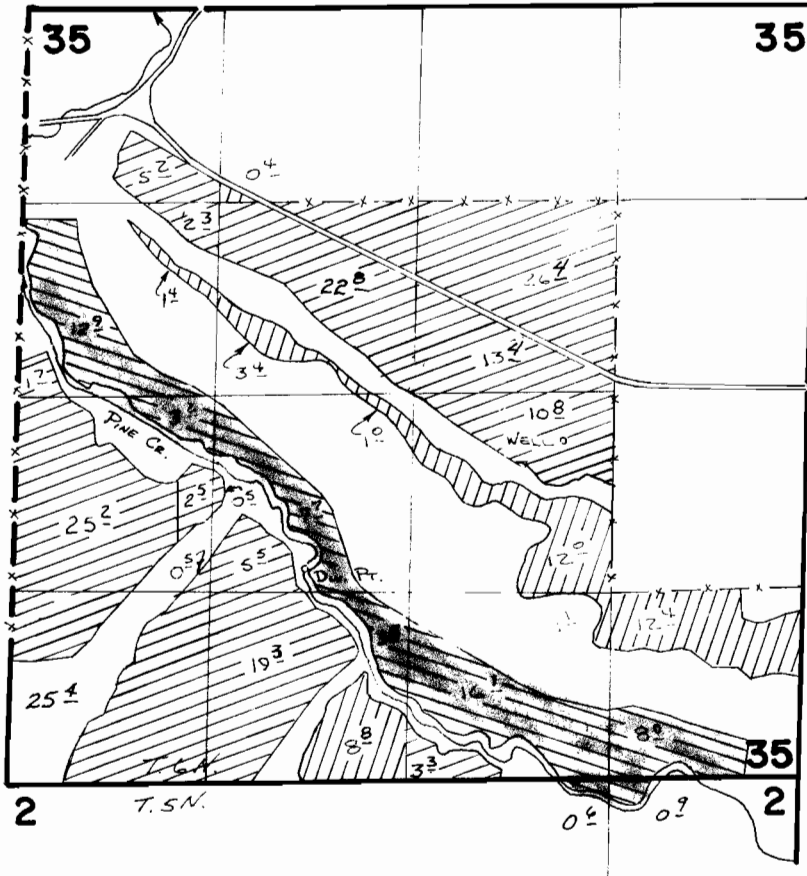

SCALE 1" = 1320'

Div. Pt. Loc: 1470' N. & 710' W. FROM 1/4 COR. SEC 35



PER. 42205



SUPPL. PER. 46984



PRI. PER. 46984

FINAL PROOF SURVEY

UNDER

PRM = 55490

55490

42205

Application No. **59671** Permit No. **46984**

IN NAME OF

ADOLF C. KLEIN

Surveyed 3-2 1987, by V. Church