


T. 58&6N., R. 34E., W.M.

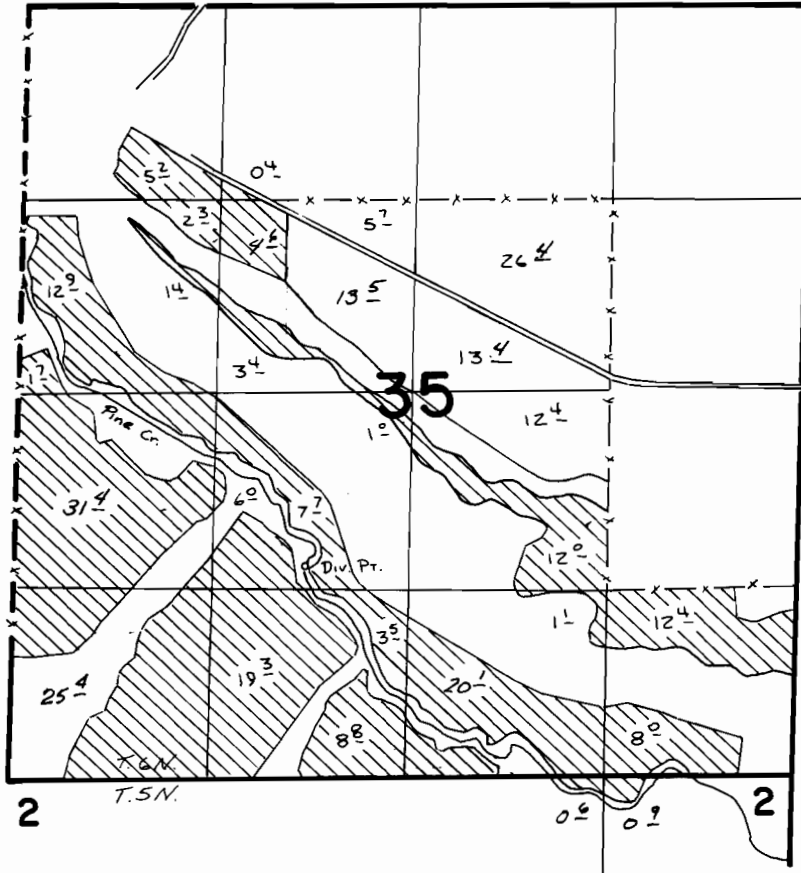

SCALE 1" = 1320'

Div. Pt. Loc: 1470N. & 710W. From 5/4 COR. Sec. 35

FINAL PROOF SURVEY UNDER

Application No. **61015**... Permit No. **46985**...
IN NAME OF

.....**ADOLF C. KLEIN**.....

Surveyed ...**3-2**..... 19**87**., by **V.L. Church**.....