


T.15S., R.11E., W.M.

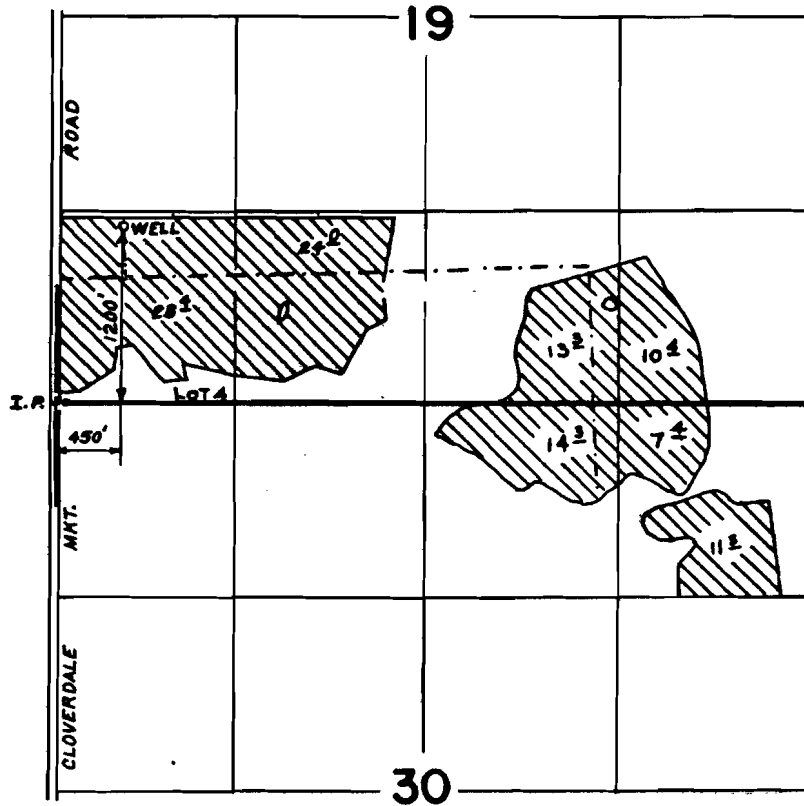

SCALE: 1" = 1320'

FINAL PROOF SURVEY UNDER

Application No. G-9587... Permit No. G-8846... Cert. #61097
IN NAME OF

.....DONALD H. VETTERLEIN.....

Surveyed FEB...28.. 19.85., by .LESLIE..OLSON..

RECEIVED

DATE 5-23-89

WATER MASTER DISTRICT #11

BY *SMS*