


T.4S.,R.1E.,W.M.

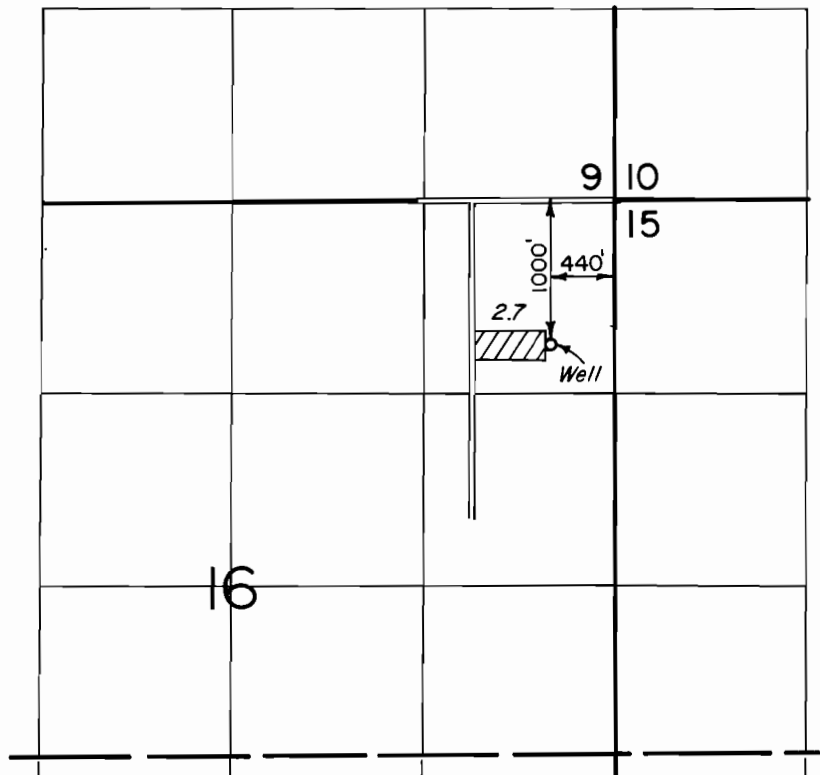

FINAL PROOF SURVEY
UNDER

Application No. G-9721 Permit No. G-8831
IN NAME OF

Joseph & Christine Deutsch

Surveyed AUG. 4, 1981, by *MB*