90684

T.17S., R.23E., W.M.

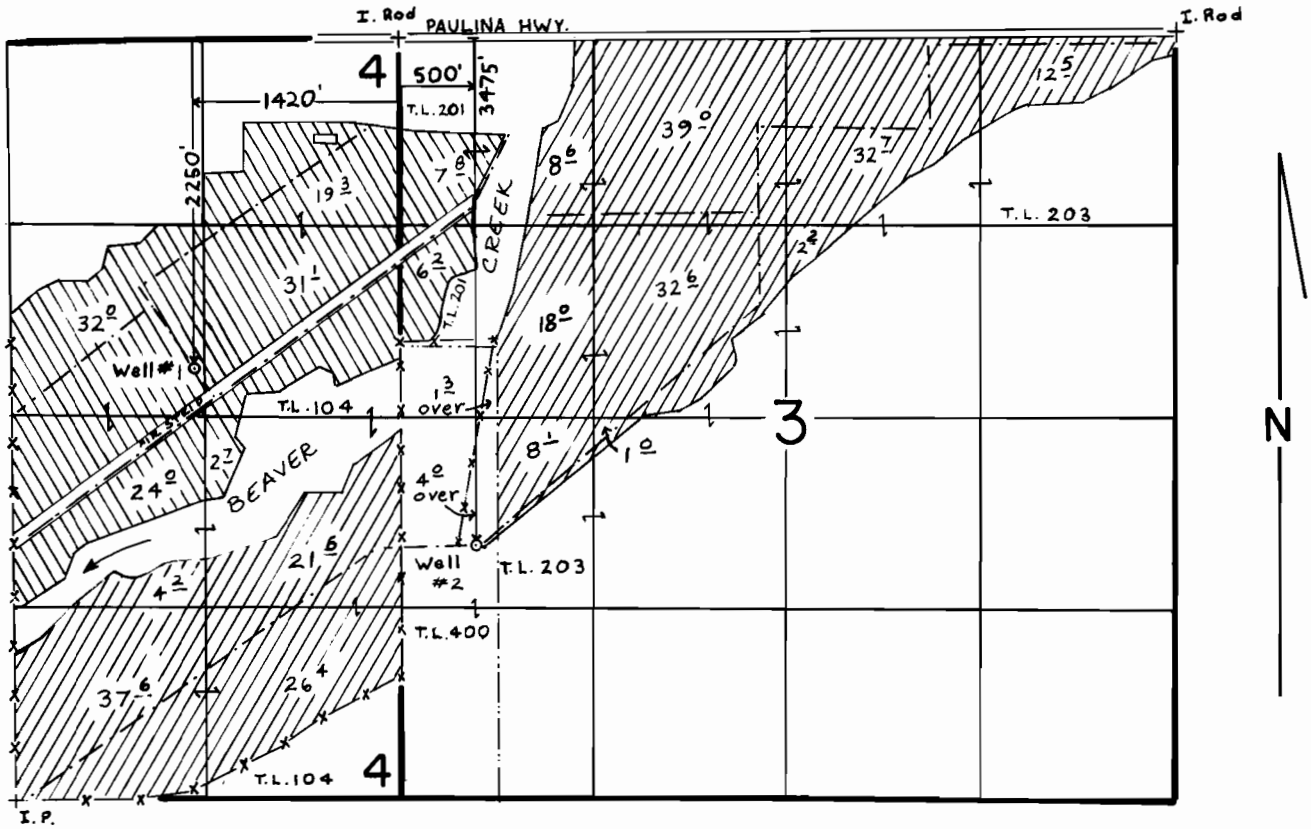

SCALE : 1" = 1320'

FINAL PROOF SURVEY

UNDER

G-9753 G-9255

Application No. G-9754 Permit No. G-9256

IN NAME OF

PAULINA RANCHES, INC.

Surveyed JULY 15 1986, by LESLIE OLSON
& AUG. 25

PTS 11-1986 A MJM