


T. 40 S., R. 8 W., W. M.

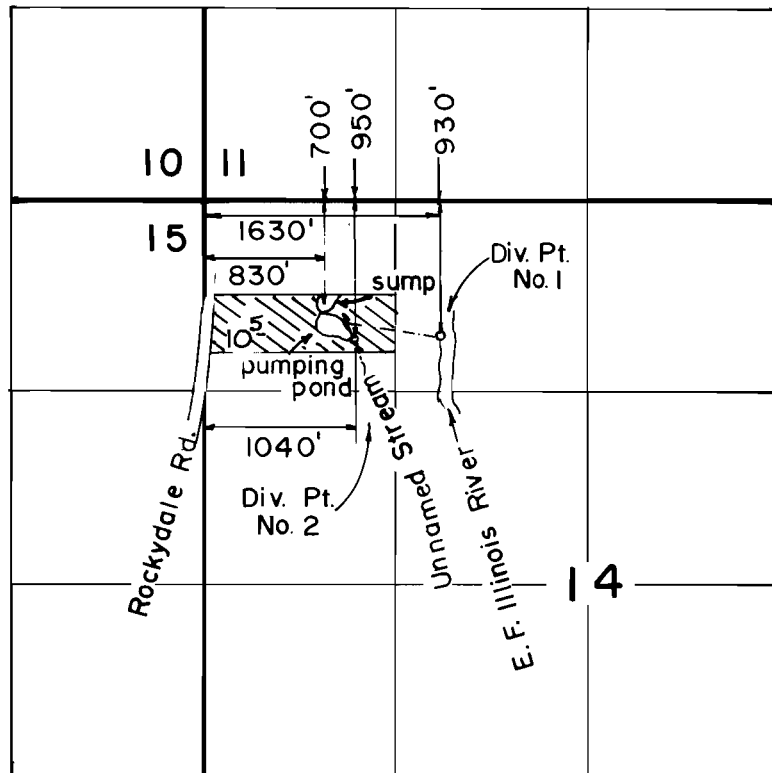

Scale: 1" = 1320'

FINAL PROOF SURVEY

UNDER

G-9830 G-9080
Application No. 60341 Permit No. 45180...
IN NAME OF

..... LOTTE KERIVAN

Surveyed APR. 17 1986, by B. S. JAMES