


T. 40 S., R. 8 W., W. M.

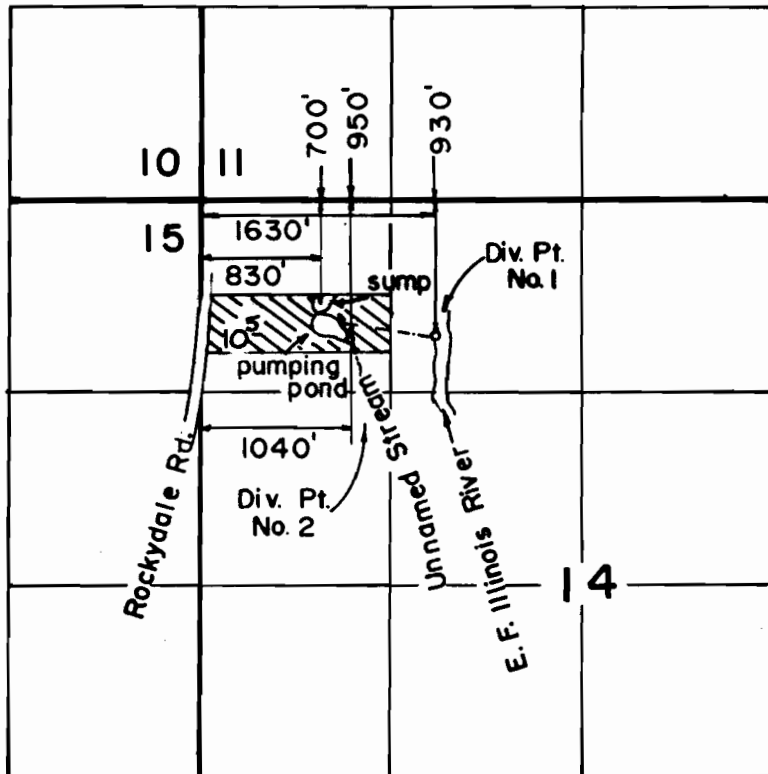

Scale: 1" = 1320'

**FINAL PROOF SURVEY**  
UNDER

G-9830                      G-9080  
Application No. 60341 Permit No. 45180...  
IN NAME OF

..... **LOTTE    KERIVAN** .....

Surveyed APR. 17. 1986, by B. S. JAMES