


T. 36 S., R. 3 W., W. M.

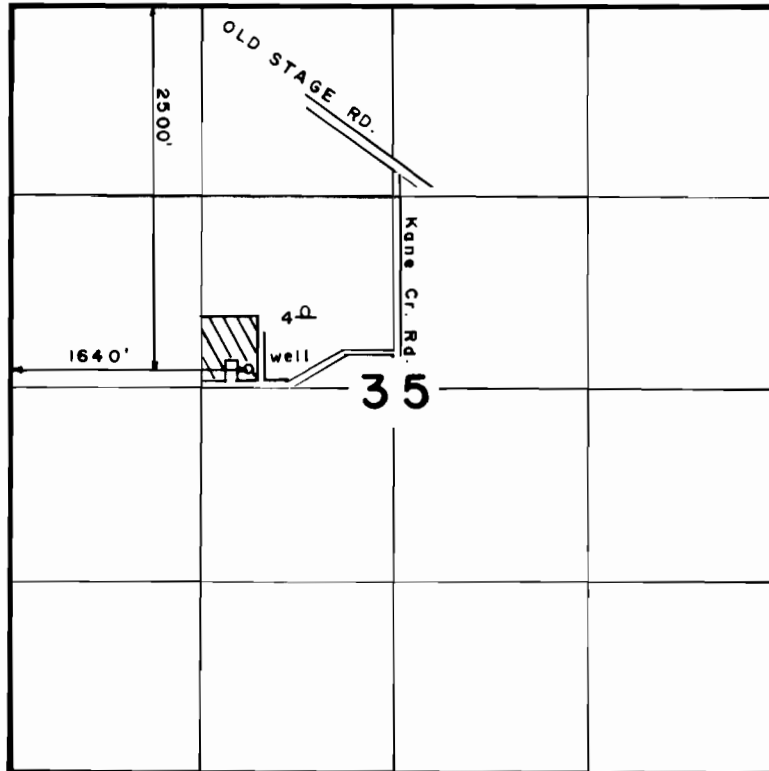

SCALE: 1" = 1320'

**FINAL PROOF SURVEY**  
UNDER

Application No. ~~G-9880~~ Permit No. G-9084  
IN NAME OF

GARY V. DEL GRANDE

Surveyed JUN. 24. 1986, by B.S. JAMES.