


T. 36 S., R. 3 W., W. M.

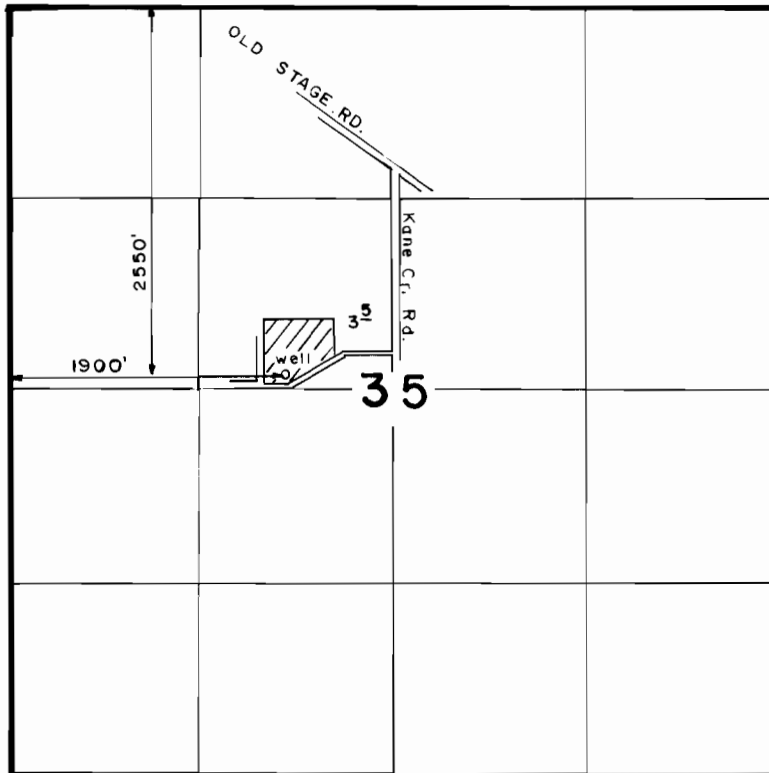

SCALE: 1" = 1320'

FINAL PROOF SURVEY
UNDER

Application No. ~~G-9884~~ Permit No. G-9085
IN NAME OF

LINDA OLDLAND

Surveyed JUN. 24. 1986, by B. S. JAMES