


T.19S.,R.2W.,W.M.

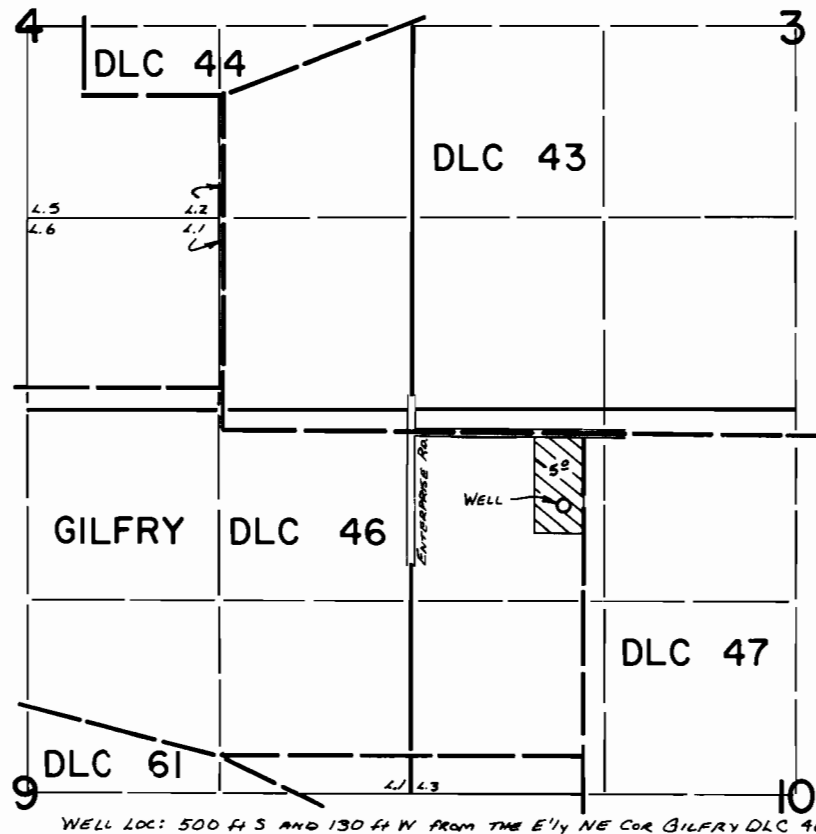

FINAL PROOF SURVEY
UNDER

Application No. G-9964, Permit No. G-9096.....
IN NAME OF

LAWRENCE H. & CAROLYN M. KANE

Surveyed Aug...19... 1981... by S.C. BROWN.....