


T. 4S., R. 1W., W.M.

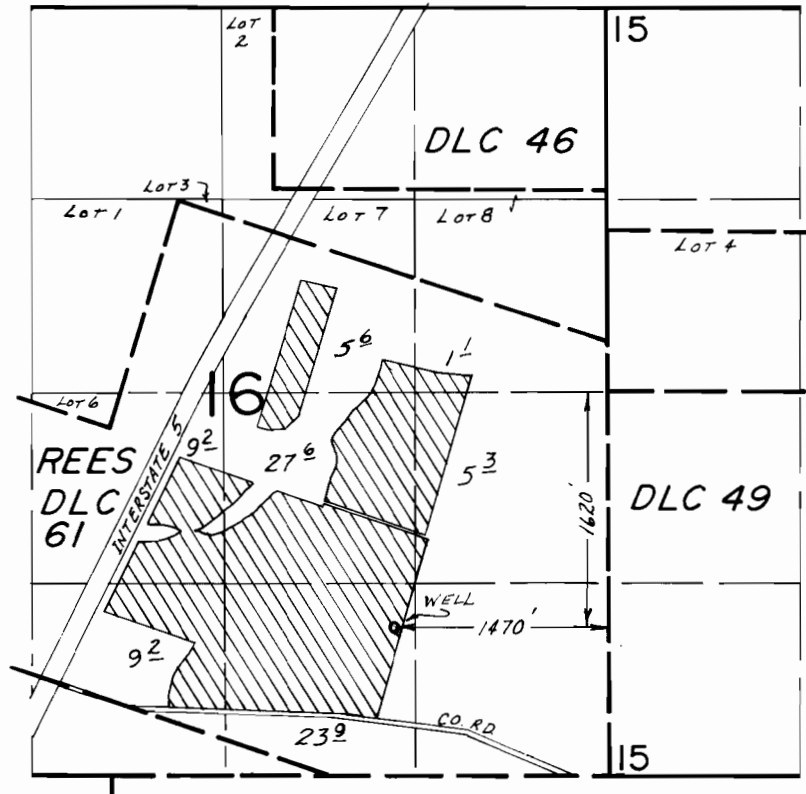

**FINAL PROOF SURVEY**  
UNDER

Application No. G-1004 Permit No. G-925.....  
IN NAME OF

THEODORE F. ZACHER.....

Surveyed OCT. 7 1983, by L. M. TOLL.....