


T.6S., R.2W., W.M.

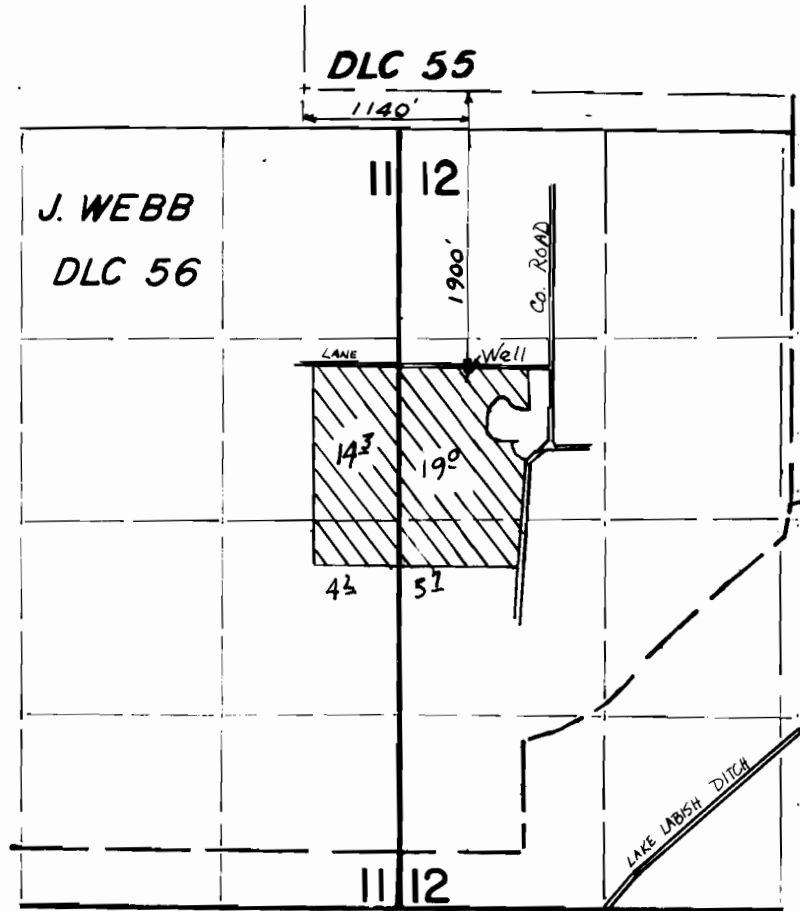

FINAL PROOF SURVEY UNDER

Application No. G.10269. Permit No. G.9282....
IN NAME OF

JAMES J. SCHLECHTER

Surveyed OCT. 26, 1983, by M. CAHILL.....