


T. 24S., R. 29E., W. M.

SCALE 1" = 1320'

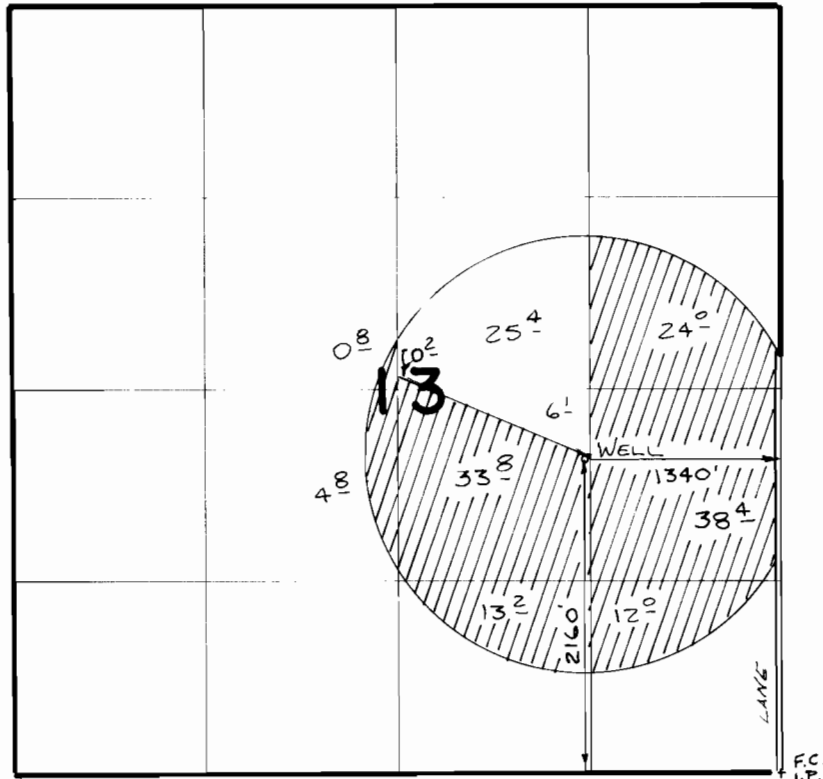

FINAL PROOF SURVEY UNDER

Application No. **G-10753** Permit No. **G-9823**
IN NAME OF

CHUCK COX

Surveyed **5-10-1988** by **B.S. James**