
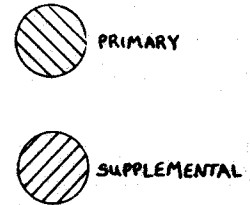
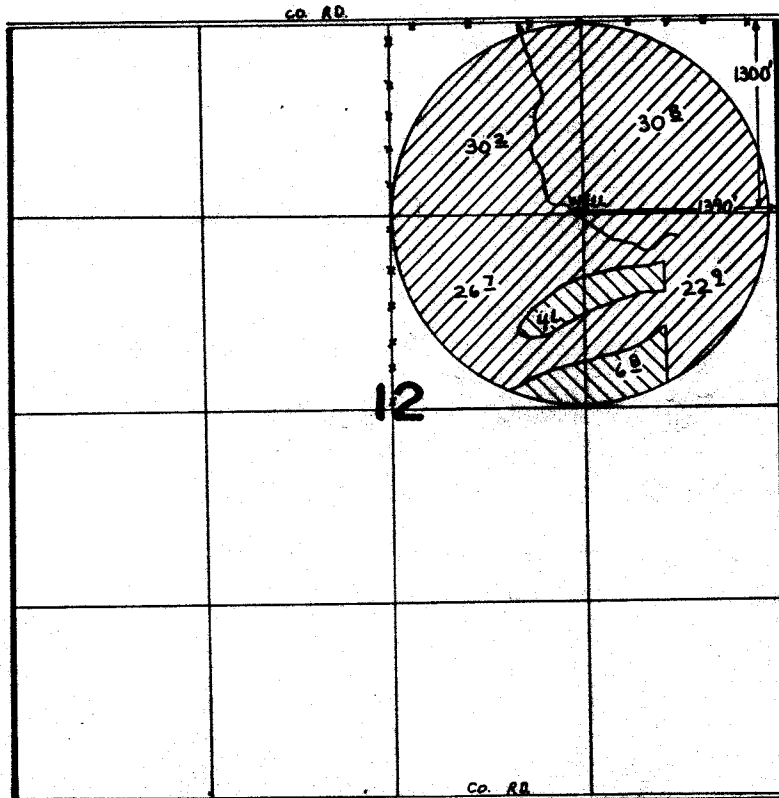


G10234
6114

T. 3 N. R. 28 E. W.M.

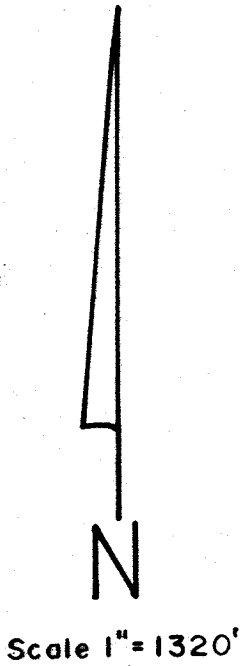

FINAL PROOF SURVEY UNDER

Application No. G11077 Permit No. G10234
IN NAME OF

...SPIKE RANCH, INCORPORATED...

Surveyed Jan...5... 1987, by V. Church.....