
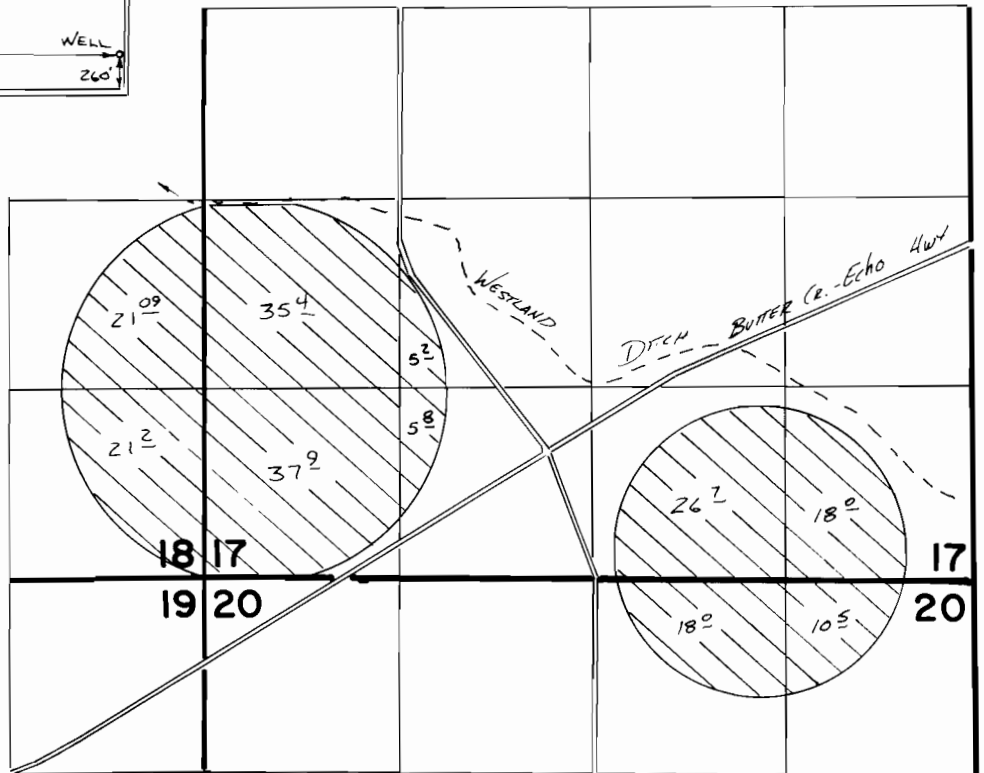


T. 3N., R. 29E., W. M.

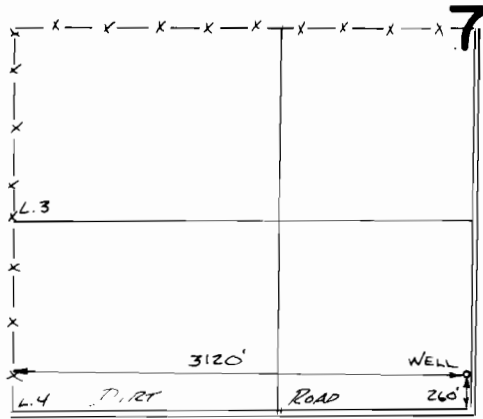

SCALE 1" = 1320'

FINAL PROOF SURVEY UNDER

Application No. **G:11457**. Permit No. **G:10664**
IN NAME OF

SPIKE RANCH, INC.

Surveyed 8-5 1987, by V.L. Church